


Map No. K Sec. 20 Twp. 25 R. 9
 Well No. 1 Ladd Farm
Mid-Kansas Oil Company

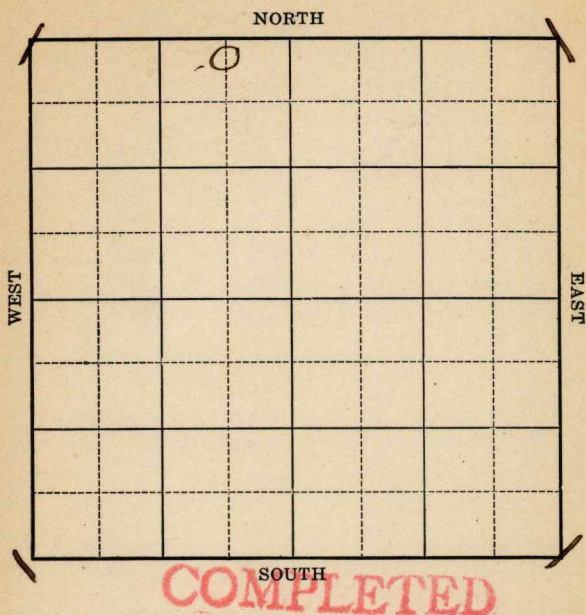

Location

Drilling Remarks:

Rig Up

Drilling Remarks:

RECORD

Cased in. ft.

Sand

Gas

Oil

• Total Depth

PRODUCTION


1st 24 hrs. Nat.

1st 24 hrs. after shot

Gas cu. ft.

Dry Hole

Abandoned

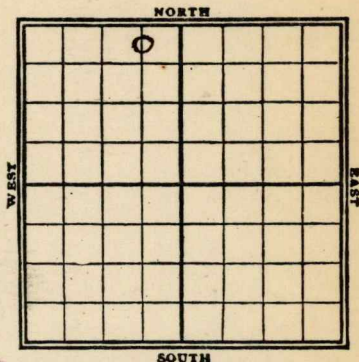Map No. K Sec. 20 Twp. 25 R. 9Well No. 1 Ladd Farm
Mid-trans. Oil Company200 Ft. from N. Line Ft. from S. Line660 Ft. from E. Line Ft. from W. LineFIRST REPORT
REPORT

Date

19208/6Rig up.8/13Log @ 350'8/21Log @ 500'8/27Log @ 550'9/3Log @ 1300'9/11Log @ 1310'9/18Log @ 1775'22Log @ 2200'29Log @ 2355-2361'29Log @ 2505'


1515-

State..... County.....

Sec. 20 Twp. 25 N-S; Rge. 9 E-W

Well No. 1 Ladd Farm.....

Mid-Kansas Oil Company.....

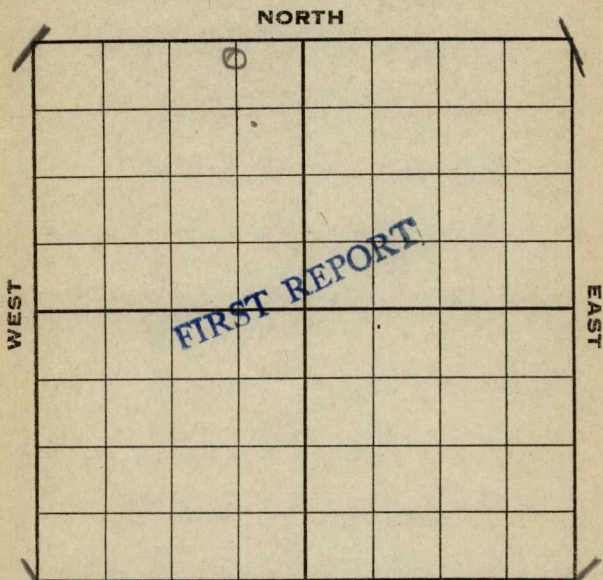

660 E
Location.....

200 N
Cased.....in.....ft.

☒ Rig up.....Mach.....

Productive Horizons
From.....To.....

Drilling at.....

Fishing at.....

U. R. to.....

S. D. at.....

Natural production.....Bbls. per.....hours

Pumping.....Gas.....Cu. ft. per 24 hours

Gauge press.....lbs. Total depth.....

Were samples collected.....

Remarks:

Map No. K15 Sec. 20 Twp. 25 R. 9Well No. 1 LaddMid-Kansas Oil Company

Contractor

SECTION PLAT

200 Ft. from N. Line

Ft. from S. Line

660 Ft. from E. Line

Ft. from W. Line

Location

Rig up

Drilling and Remarks:

RECORD

Cased _____ in., _____ ft

Sand _____

Gas _____

Oil _____

Total Depth _____

PRODUCTION

1st 24 hrs. Nat. _____

1st 24 hrs. after shot _____

Gas _____ Cu. Ft

Dry Hole 2505

Abandoned _____

Gas Sand 2355
2362

Date

9/29 19120

Pyle

Scout