


Map No. Kan Sec. 20 Twp. 25 R. 9
 Well No. 4 C Ladd Acct #3 Farm
Mid Kansas Company

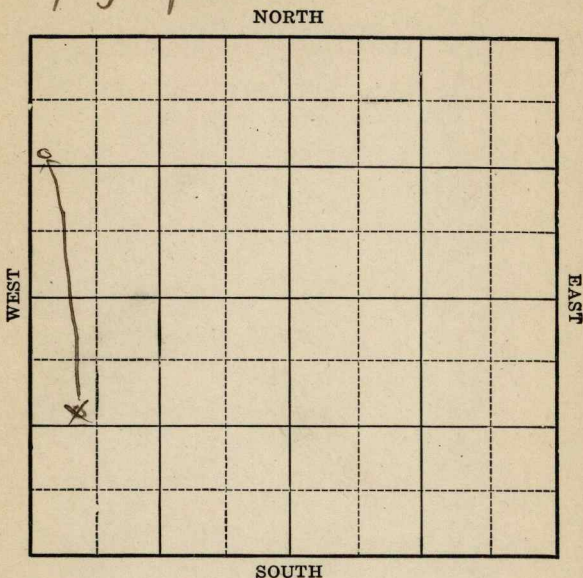

Location _____

Drilling Remarks _____

RECORD

Cased _____ in. _____ ft.

Sand _____

Gas _____

Oil _____

Total Depth _____

Rig Up _____

Drilling Remarks _____

PRODUCTION

1st 24 hrs. Nat. _____

1st. 24 hrs. after shot _____

Gas _____ cu. ft.


Dry Hole _____

Abandoned _____

Map No. Kan Sec. 20 Twp. 25 R. 9Well No. 4 C Ladd Ac't. #3 Farm
Mid Kansas Company845 Ft. from N. Line

Ft. from S. Line

Ft. from E. Line

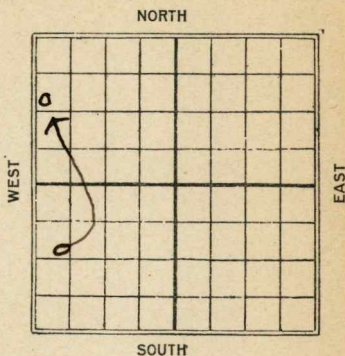580 Ft. from W. LineCDate
1925

REPORT

7/3 Location7/10 Rign up7/17 3007/24 600'7/31 1200'8/7 -1900'8/14 sand 2326 - 45'Brakw sand 2345 - 95'Oil 2395 - 2415'40/150 bbls

Map No. 15 Kansas Sec. 20 Twp. 25 R. 9Well No. 4 C. Ladd. Sect #3.Mid-Kansas Company

Contractor

FIRST REPORTS

SECTION PLAT

845 Ft. from N. Line

Ft. from S. Line

Ft. from E. Line

580 Ft. from W. Line

Location ☒

Rig up

Drilling and Remarks:

RECORD

Cased _____ in., _____ ft.

Sand _____

Gas _____

Oil _____

Total Depth _____

PRODUCTION

1st 24 hrs. Nat. _____

1st 24 hrs. after shot _____

Gas _____ Cu. Ft.

Dry Hole _____

Abandoned _____

Date

JUL 3 1925

192

CHAS. L. SHERWOOD

Scout

Map No. 1544 Sec. 20 Twp. 25 R. 9
 Well No. 4 "C" Ladd, Acct #3
Prod: Jan 20 Company _____

Contractor _____

SECTION PLAT

845 Ft. from N. Line
 _____ Ft. from S. Line
 _____ Ft. from E. Line
580 Ft. from W. Line

CORRECTION

Location _____
 Rig up _____
 Drilling and Remarks:
Megging up
by loc to
above,

RECORD

Cased _____ in., _____ ft.
 Sand _____
 Gas _____
 Oil _____
 Total Depth _____

PRODUCTION

1st 24 hrs. Nat. _____
 1st 24 hrs. after shot _____
 Gas _____ Cu. Ft.
 Dry Hole _____
 Abandoned _____

Date

JUL 10 1925 **CHAS. L. SHERWOOD**
 _____ 1925 _____ Scout

Form 26-1M Bks.-3-23-11959. *Menward Co*
 Map No. **KANSAS** Sec. *20* Twp. *25* R. *9*
 Well No. *4 "C" Ladd, Acct #3*
Mid-Santa Company
 Contractor

COMPLETED

SECTION PLAT

845 Ft. from N. Line
 _____ Ft. from S. Line
 _____ Ft. from E. Line
580 Ft. from W. Line

<i>0.</i>			

Location _____
 Rig up _____
 Drilling and Remarks:

Sand 2336-45'
Broken at 2345-95'
oil 2395-2415'
401
150 bhs.

RECORD

Cased _____ in., _____ ft.
 Sand *2336* _____
 Gas _____
 Oil _____
 Total Depth _____

PRODUCTION

1st 24 hrs. Nat. _____
 1st 24 hrs. after shot _____
 Gas _____ Cu. Ft.
 Dry Hole _____
 Abandoned _____

Date
AUG 14 1925 **CHAS. L. SHERWOOD**
 _____ 192 _____ Scout