

KANSAS


Barton

FORM 51 IOM 12-46 PETROL

Section 32 Township 20 Range 15N

Well No. 1 Mosbarger

Company Magnolia

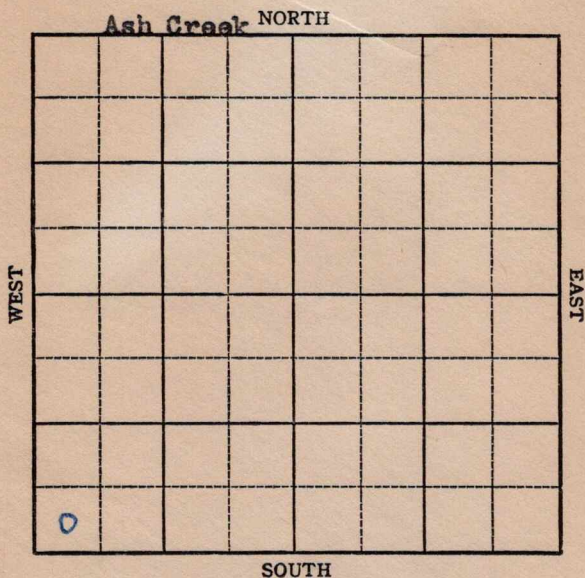

KANSAS

Sec. 32 Twp. 20 R. 15W

Well No. #1 Mosbarger Farm

Magnolia Company

Ash Creek

Ft. from N. Line

330


Ft. from S. Line

Ft. from E. Line

330

Ft. from W. Line

SW/c

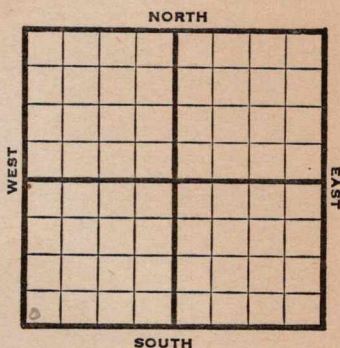

1947

Elev. 2006'

REPORT

9/10 Location

9/17 "

9/24 "

10/1 RUR

10/8 9" @ 1035'

Drlg. 2390'

10/15 Drlg. 3455'

10/22 Lansing 3443'

Viola 3726'

Simpson 3754'

Arbuckle 3792'

DST 3819-29 open 40 minutes

Rec 2600' oil 5" @ 3879

RUST

11/5 Arbuckle 3792'

5" @ 3819'

Flow 115 Pot

Gr. 38°

Total Depth 3829'

COMPLETED

Map No. _____ Sec. 32 Twp. 20 R. 15W

Well No. 1 Mosbarger

Magnolia Company

FIRST REPORT Contractor

SW/c


SECTION PLAT

_____ Ft. from N. Line

330 Ft. from S. Line

_____ Ft. from E. Line

330 Ft. from W. Line

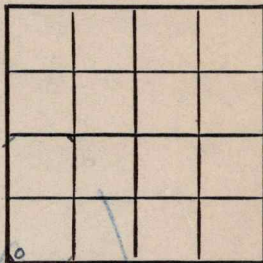

Barton County

Location X

Rig up _____

Drilling and Remarks:

RECORD

Cased _____ in., _____ ft.

Sand _____

Gas _____

Oil _____

Total Depth _____

PRODUCTION

1st 24 hrs. Nat. _____

1st 24 hrs. after shot _____

Gas _____ Cu. Ft.

Dry Hole _____

Abandoned _____

Date

SEP 10 1947 19

S. J. LEWIS Scout

Kansas


Map No. 82 Sec. 32 Twp. 20 R. 15WWell No. 1 MosbargerMagnolia

Company

COMPLETE

Contractor

SW/C

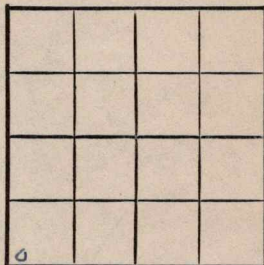E1.2006
SECTION PLAT Ft. from N. Line330 Ft. from S. Line Ft. from E. Line330 Ft. from W. LineBarton CountyLocation Rig up

Drilling and Remarks:

Per 837925' 103879Flow 115 Bx3829

RECORD

Cased in., ft.Sand Gas Oil Total Depth 3829

PRODUCTION

1st 24 hrs. Nat. 1st 24 hrs. after shot Gas Cu. Ft.Dry Hole Abandoned

Date

NOV 5 1947 19S. J. LEWIS Scout