

KANSAS Ellis

O.W.W.O.

Sec. 14 Twp. 11 R. 18W

Well No. #1 Peavey
#1 Lynn Farm

Derby & N.W. Gore
Harry Gore Company

Burnett


Ft. from N. Line

330 Ft. from S. Line

Ft. from E. Line

330 Ft. from W. Line

SW/C

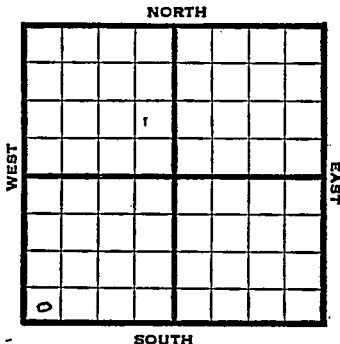

1947

Elev. 1935 REPORT

12/3

10" @ 216'
Drlg. 350'

12/10

Drlg. 3000'

12/17

Lansing 3178
Simpson 3469
Arbuckle 3503
TD 3528'

ABANDONED

1952

O.W.W.O.

1/30

Arb. 3504' OTD 3528' was D & A
DD Reagan 3633' TD 4042'
5" @ 3592' CO 4042'
Comp. for SWD

FIRST REPORT

COMPLETED

2, 0.

Map No. _____ Sec. 14 Twp. 11 R. 18WWell No. 1 LynnHarry Gore CompanyFIRST REPORT Contractor


SW/C

SECTION PLAT

_____ Ft. from N. Line

330 Ft. from S. Line

_____ Ft. from E. Line

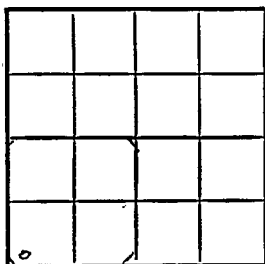330 Ft. from W. LineEllis County

Location _____

Rig up _____

Drilling and Remarks:

10" @ 216

drlg. 350

RECORD

Cased _____ in., _____ ft.

Sand _____

Gas _____

Oil _____

Total Depth _____

PRODUCTION

1st 24 hrs. Nat. _____

1st 24 hrs. after shot _____

Gas _____ Cu. Ft.

Dry Hole _____

Abandoned _____

Date

DEC 3 1947 19S. J. LEWIS Scout

Map No. 7 / Sec. 14 Twp. 11 R. 18W

Well No. 1 Lynn

Harry Gore Company

ABANDONED Contractor

SW/C

E. 11985
SECTION PLAT

_____ Ft. from N. Line

330 Ft. from S. Line

_____ Ft. from E. Line

330 Ft. from W. Line

Ellis County

Location _____

Rig up _____

Drilling and Remarks: _____

Lans 8178
Swif 8469
At 40500

RECORD

Cased _____ in., _____ ft.

Sand _____

Gas _____

Oil _____

Total Depth 3528

PRODUCTION

1st 24 hrs. Nat. _____

1st 24 hrs. after shot _____

Gas _____ Cu. Ft.

Dry Hole _____

Abandoned _____

Date

DEC 17 1947 19

S. J. LEWIS Scout

County **Ellis** State **Kansas**

Sec. **14** (Blk. Twp.) **11** (Sur. Rge.) **18W** Map No.

Operator **Derby & H. W. Gore**

Well No. **I** Farm **Peavey**

Elev. **1935** Location **SW SW SW**

FIRST REPORT COMPLETE									
0									

330 Ft. From **S** Line **SW**

330 Ft. From **W** Line Quarter

1st. Report. **JAN 3 0 1952**

Completion. **JAN 3 0 1952**

Remarks **O.W.W.O.**

O.W.W.O.

Spudding Date

Drlg. Data

Arb 3504 OTD 3528 was D&A DD Reagan 3633

T.D. 4042 5" @ 3592 G.O. 4042 Comp. for

SWD

J. G. McGEHEE