


Map No. KANSAS Sec. 36 Twp. 24 R. 12
 Well No. 1-Steckel Farm
Bisagno et al Company

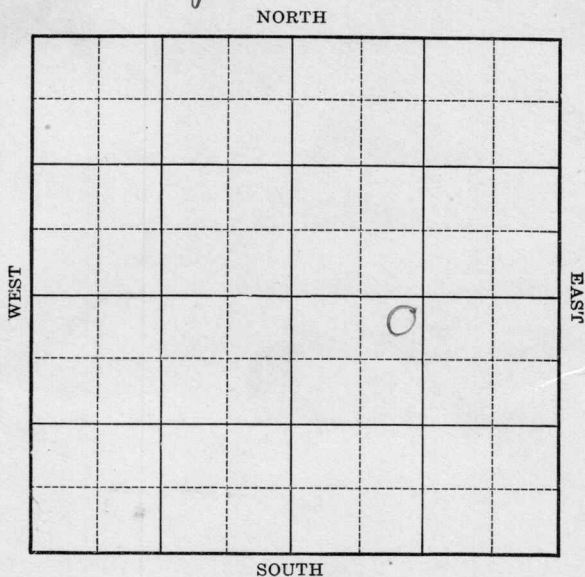

Location _____

Drilling Remarks _____

Rig Up _____

Drilling Remarks _____

RECORD

Cased _____ in. _____ ft.

Sand _____

Gas _____

Oil _____

Total Depth _____

PRODUCTION

1st 24 hrs. Nat. _____

1st 24 hrs. after shot _____

Gas _____ cu. ft.

Dry Hole _____

Abandoned _____

Map No. KANSAS Sec. 36 Twp. 24 R. 12Well No. 1 - Stechel Farm
Bisagno et al Company

NORTH

WEST

EAST

SOUTH

220 Ft. from N. Line

_____ Ft. from S. Line

_____ Ft. from E. Line

1020 Ft. from W. Line1927

Date

REPORT

10/19	Location
10/27	_____
11/2	_____
11/9	_____
11/16	Rigging up-
11/23	Rigged up & S.D.
11/30	Drilg 320'
12/7	" 775'
12/14	S.D. 900' - water line froze
12/21	Drilg 1100-
12/29	" 1300
1928	
1/5	S.D. 1400-
1/11	Top line 1706 break 1709 150' Oil in hole
1/18	Top line 1706 - 1st break 1715-38. T.D. 1742 - Swab 40 bbl natural - Shot 60 qts - Cleaning out -
1/26	1715 - 1738 T.D. 1742 Top line 1706 60/15 bbls

16 KANSAS Sec. 36 Twp. 24 R. 12 E

Well No. 1 Steckel
Disagno et al Company

Contractor

FIRST REPORTS


SECTION PLAT

220 Ft. from N. Line

Ft. from S. Line

Ft. from E. Line

1020 Ft. from W. Line

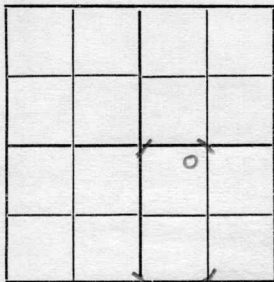

Location ✓

Rig up

Drilling and Remarks:

RECORD

Cased in., ft.

Sand

Gas

Oil

Total Depth

PRODUCTION

1st 24 hrs. Nat.

1st 24 hrs. after shot

Gas Cu. Ft.

Dry Hole

Abandoned

Date

OCT 19 1927

CHAS. L. SHERWOOD

192

Scout

Map No. 16 KANSAS Sec. 36 Twp. 24 R. 12

Well No. 1 Steele

Bisagno et al Company

Contractor

COMPLETED

220 Ft. from N. Line

_____ Ft. from S. Line

_____ Ft. from E. Line

1020 Ft. from W. Line

SECTION PLAT

		o	

Location _____

Rig up _____

Drilling and Remarks:

Topump 1706

60/15 Bl.

RECORD

Cased _____ in., _____ ft.

Sand 1715-1738

Gas _____

Oil _____

Total Depth 1742

PRODUCTION

1st 24 hrs. Nat. _____

1st 24 hrs. after shot _____

Gas _____ Cu. Ft.

Dry Hole _____

Abandoned _____

Date

JAN 26 1928

192

CHAS. L. SHERWOOD

Scout