


Map No. 100 Sec. 20 Twp. 25 R. 9

Well No. 5 Ladd Acre #3 Farm

Mid-Kansas Company

NORTH

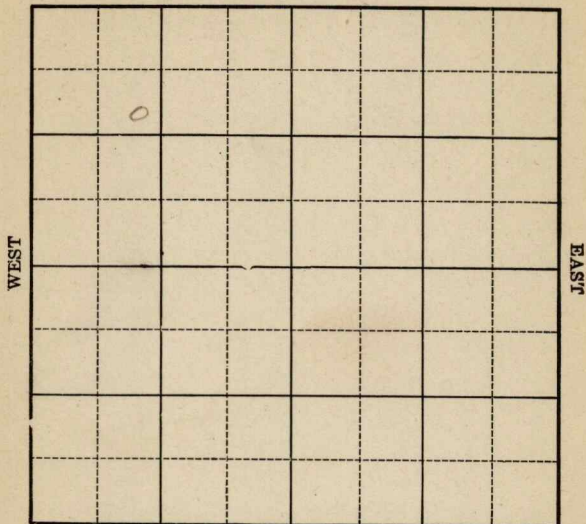

SOUTH

Location -----

Drilling Remarks

Rig Up_____

Drilling Remarks

RECORD

Cased_____in. _____ft.

Sand

Gas

Oil

Total Depth

PRODUCTION

1st 24 hrs. Nat.-----

1st 24 hrs. after shot -----

Gas.....cu. ft.

Dry Hole_____

Abandoned -----


Map No. **KANSAS** Sec. **20** Twp. **25** R. **9**
 Well No. **5 Land acct # 3** Farm
Mid-Kansas Company

825
~~**857**~~ Ft. from N. Line

_____ Ft. from S. Line

_____ Ft. from E. Line

1180' Ft. from W. Line

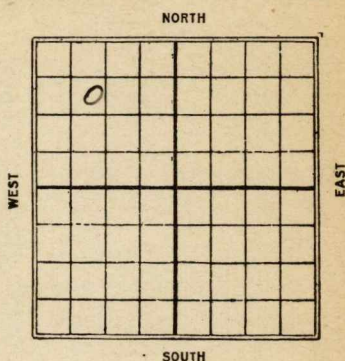

Date _____ REPORT

8/26 Location

9/3 Rig

9/11 Rig

9/16

9/24 spud dring

10/4 Spooling 100

10/8

10/16 Lrly 1200

11/6 Sand 2360-2426
120 gts 40 Bbls

Map No. KANSAS Sec. 20 Twp. 25 R. 9
 Well No. 5 Ladd. Acct #3
Mid-Kansas Company

Contractor

FIRST REPORTS

SECTION PLAT

845 Ft. from N. Line

----- Ft. from S. Line

----- Ft. from E. Line

1180 Ft. from W. Line

0			

Location ☒ -----

Rig up -----

Drilling and Remarks:

RECORD

Cased ----- in., ----- ft.

Sand -----

Gas -----

Oil -----

Total Depth -----

PRODUCTION

1st 24 hrs. Nat. -----

1st 24 hrs. after shot -----

Gas ----- Cu. Ft.

Dry Hole -----

Abandoned -----

Date

AUG 27 1925

192

CHAS. L. SHERWOOD

Scout

Benwood Co
 Map No. *K15* KANSAS Sec. *20* Twp. *25* R. *9*
 Well No. *5* *Ladd* Acct. # *3*
Mid-Sandoo Company

Contractor

COMPLETED

SECTION PLAT

845 Ft. from N. Line

----- Ft. from S. Line

----- Ft. from E. Line

1180 Ft. from W. Line

Location -----

Rig up -----

Drilling and Remarks:

RECORD

Cased *2360-2426* in., ft.

Sand

Gas -----

Oil -----

Total Depth *2426* -----

PRODUCTION

1st 24 hrs. Nat. -----

1st 24 hrs. after shot -----

Gas ----- Cu. Ft.

Dry Hole -----

Abandoned -----

Date

NOV 6 1925 CHAS. L. SHERWOOD
 192 Scout