

Map No. **KANSAS** Sec. **4** Twp. **24** R. **13**
Well No. **1 - Smith** Farm
Blay et al Company

NORTH

A hand-drawn diagram on a grid. A horizontal line with an arrow pointing to the right is drawn across the middle of the grid. At the left end of this line is a circle with an 'X' inside it. At the right end is a circle with a dot inside it. The word 'WEST' is written vertically along the left edge of the grid, and the word 'EAST' is written vertically along the right edge of the grid.

SOUTH

Location _____

Drilling Remarks

Rig Up_____

Drilling Remarks

RECORD

Cased _____ in. _____ ft.

Sand

Gas

Oil

Total Depth

PRODUCTION

1st 24 hrs. Nat. _____

1st 24 hrs. after shot_____

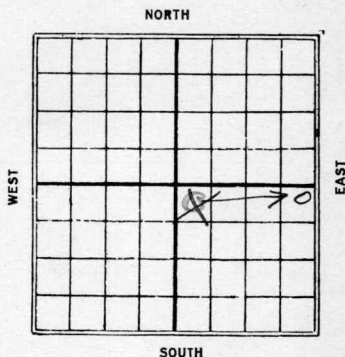
Gas_____cu. ft.

Dry Hole

Abandoned -----

Map No. KANSAS Sec. 4 Twp. 24 R. 13Well No. 1-Smith Farm
Bly et al Company330 Ft. from N. Line

Ft. from S. Line

330 Ft. from E. Line330 Ft. from W. Line1928

Date

REPORT

1/6	Location
1/11	
1/18	Rigging up machine
1/26	Spudding
2/2	S.A. 350
2/9	Drlg 805-
2/16	S.A. 1150
2/23	
3/1	Fishing 1250
3/8	Drlg 1600
3/15	Top line 1704
	N.A. 1801

Sherwood

E

Map No. 2 Sec. 4 Twp. 24 R. 13

Well No. 1 Smith
Bly et AL Company

Contractor

FIRST REPORTS

SECTION PLAT

		0	

320

Ft. from N. Line

Ft. from S. Line

Ft. from E. Line

320

Ft. from W. Line

Location ☒

Rig up

Drilling and Remarks:

RECORD

Cased _____ in., _____ ft.

Sand _____

Gas _____

Oil _____

Total Depth _____

PRODUCTION

1st 24 hrs. Nat. _____

1st 24 hrs. after shot _____

Gas _____ Cu. Ft.

Dry Hole _____

Abandoned _____

Date

JAN 6 1928

CHAS. L. SHERWOOD

Scout

Sherwood

Map
KANSAS

Map No. _____ Sec. 4 Twp. 24 R. 13

Well No. 1 *Smith*

Bly et AL

Company

Contractor

CORRECTION

330

_____ Ft. from N. Line

_____ Ft. from S. Line

330

_____ Ft. from E. Line

_____ Ft. from W. Line

SECTION PLAT

		0 → 0	

Location _____

Rig up *leg up*

Drilling and Remarks:

chg location

RECORD

Cased _____ in., _____ ft.

Sand _____

Gas _____

Oil _____

Total Depth _____

PRODUCTION

1st 24 hrs. Nat. _____

1st 24 hrs. after shot _____

Gas _____ Cu. Ft.

Dry Hole _____

Abandoned _____

Date

JAN 13 1928

192

CHAS. L. SHERWOOD
Scout

Map No. Sec. 4 Twp. 24 R. 13

Well No. Smith

By O. H. W. Company

Contractor

COMPLETED

SECTION PLAT

330 Ft. from N. Line

_____ Ft. from S. Line

330 Ft. from E. Line

_____ Ft. from W. Line

ABANDONED

			o

Location _____

Rig up _____

Drilling and Remarks:

Top line 1704

DDW 1801

RECORD

Cased _____ in., _____ ft.

Sand _____

Gas _____

Oil _____

Total Depth 1801

PRODUCTION

1st 24 hrs. Nat. _____

1st 24 hrs. after shot _____

Gas _____ Cu. Ft.

Dry Hole ☒

Abandoned _____

Date

MAR 15 1928

192

CHAS. L. SHERWOOD

Scout