


Map No. _____ Sec. 25 Twp. 25 R. 9
Well No. 1 Singleton Farm _____
Hutton Regan Company _____

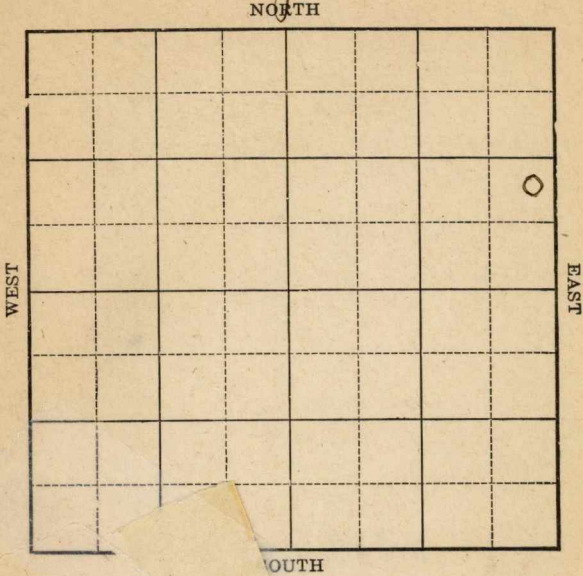

Location _____
Drilling Remarks: _____

Rig Up _____
Drilling Remarks: _____

RECORD


Cased _____ in. _____ ft.
Sand _____
Gas _____
Oil _____
Total Depth _____

PRODUCTION

1st 24 hrs. Nat. _____
1st 24 hrs. after shot _____
Gas _____ cu. ft.
Dry Hole _____
Abandoned _____

Map No. _____ Sec. 25 Twp. 25 R. 9
Well No. 1 Singleton Farm _____
Hutton Regan Company _____

_____ Ft. from N. Line
1120 Ft. from S. Line
200 Ft. from E. Line
_____ Ft. from W. Line

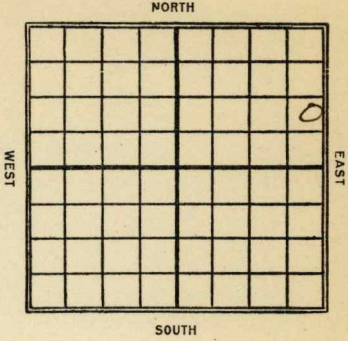

Date	REPORT
1923	
2/6	<u>Location.</u>
6/23	<u>D.A. 2165</u>

Map No. KANSAS 15 Sec. 25 Twp. 25 R. 9Well No. 1 Sighton
Huttons Regan Company
Contractor

FIRST REPORT

-----Ft. from N. Line

1120' Ft. from S. Line200' Ft. from E. Line

-----Ft. from W. Line

SECTION PLAT

			0

Location L L

Rig up -----

Drilling and Remarks:

RECORD

Cased ----- in., ----- ft.

Sand -----

Gas -----

Oil -----

Total Depth -----

PRODUCTION

1st 24 hrs. Nat. -----

1st 24 hrs. after shot -----

Gas ----- Cu. Ft.

Dry Hole -----

Abandoned -----

Date

FEB 6 1929

M. A. BENEAR

-----191-----

Scout

Map No. 15 25 Sec. 25 Twp. 9 R. 9
 Well No. 1 Singleton
Hutton & Regan Company
 Contractor

ABANDONED SECTION PLAT

_____ Ft. from N. Line
1120 Ft. from S. Line
200 Ft. from E. Line
 _____ Ft. from W. Line

			6

Location _____

Rig up _____

Drilling and Remarks:

LOV 9
2163

RECORD

Cased _____ in., _____ ft.
 Sand _____
 Gas _____
 Oil _____
 Total Depth _____

PRODUCTION

1st 24 hrs. Nat. _____
 1st 24 hrs. after shot _____
 Gas _____ Cu. Ft.
 Dry Hole _____
 Abandoned _____

Date _____

JUN 23 1922

M. A. BENEAR

Scout