


Section 34 Township 20 Range 15W

Well No. #1 Bowman

Company Rupp-Ferguson

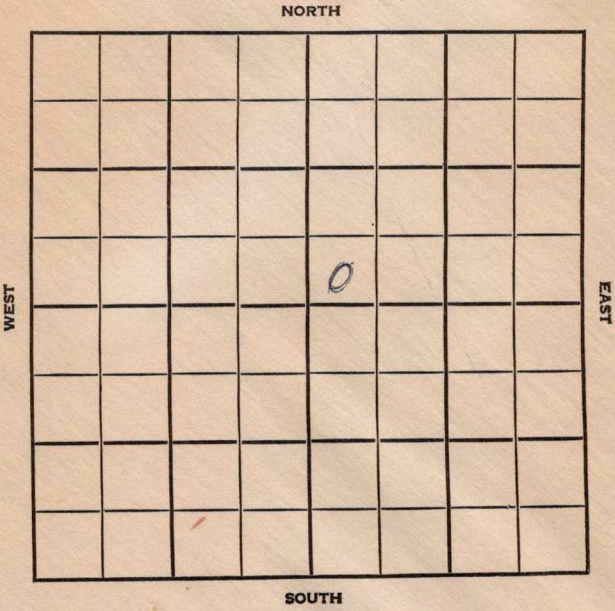

~~WILDCAT~~

County Barton Elev. 1941 DF

Sec. 34 Twp. 20 Rge. 15W

Company Hupp-Ferguson

FarmName Bowman No. 1

TOPS	DEPTH	LOG	DATUM
Anh.			
Tp.			
H.	3269		
Tr.			
Dg.			
Bl.			
L.			
K.C.			
B.K.C.			
Ce.			
C.			
M.			
M.			
K.			
Mz.			
Mo.			
V.			
S.			
S.			
A.			
R.			
Pe.			
G.			
T.D.			

Loc. in Sec. _____

SW SW NE

Geol. _____

Contr. _____

Co. Tools

Pool _____

Wildcat

OCT 31 56	
0	
FIRST REPORT	

Date Comm. spd. 10-23-56

8" @ 924 w/400, Drlg. 3373

NOV 5 1956

13

R. G.

Co.

Lse.

No.

Sec.

T.

R.

County Barton Elev. 1941 DF
 Sec. 34 Twp. 20 Rge. 15W
 Company Rupp-Ferguson
 Farm Name Bowman No. 1

TOPS	DEPTH	LOG	DATUM	Loc in Sec.
Anh.				SW SW NE
TP.	3269			
H.				
Tr.				
Dg.				
BL.	3266			
L.	3382			
K.C.				Geol.
B.K.C.				Contr.
Ce.				Co. Tools
C.	3632			Pool
M.				Wildcat
M.				<div style="border: 1px solid black; padding: 5px; text-align: center;"> ABANDONED NOV 7 '56 </div>
K.				
Mz.				
Ma.				
V.				
S.				
S.				
A	3704			
R.				
PE.				
G.				
TD.	3725			

Date Comm. spd. 10-23-56
8" @ 924 w/400, Drlg. 3373 NOV 7 '56

DST 3705-25 1hr rec 2520'
sulph. wt 1090/15"

DEA