


Map No. *Kansas* Sec. *20* Twp. *25* R. *9*

Well No. *P Ladd, acct # 3* Farm _____
Mid-Kansas Company _____

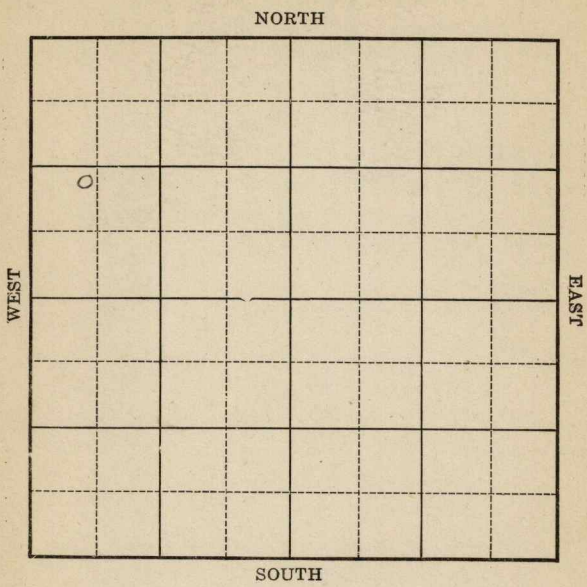

Location _____

Drilling Remarks _____

Rig Up _____

Drilling Remarks _____

RECORD

Cased _____ in. _____ ft.

Sand _____

Gas _____

Oil _____

Total Depth _____

PRODUCTION

1st 24 hrs. Nat. _____

1st 24 hrs. after shot _____

Gas _____ cu. ft.

Dry Hole _____

Abandoned _____

Sherwood

K15 KANSAS Sec. *20* Twp. *25* R. *9*

Well No. *8 Ladd. Sect #3*

Mid-San Gas Company

Contractor

FIRST REPORTS

SECTION PLAT

_____ Ft. from N. Line

1260

_____ Ft. from S. Line

_____ Ft. from E. Line

655

_____ Ft. from W. Line

o			

Location

Rig up _____

Drilling and Remarks:

RECORD

Cased _____ in., _____ ft.

Sand _____

Gas _____

Oil _____

Total Depth _____

PRODUCTION

1st 24 hrs. Nat. _____

1st 24 hrs. after shot _____

Gas _____ Cu. Ft.

Dry Hole _____

Abandoned _____

Date

APR 7 1926

CHAS. L. SHERWOOD

192

Scout

Albenwood

K15 KANSAS Map No. Sec. *20* Twp. *25* R. *9*

Well No. *8 Ladd Acct #3*

Mid-Kansas Company

Contractor

COMPLETED

SECTION PLAT

Ft. from N. Line

1260

Ft. from S. Line

Ft. from E. Line

655

Ft. from W. Line

<i>0</i>			

Location -----

Rig up -----

Drilling and Remarks:

100/100 ss.

RECORD

Cased ----- in., ----- ft.

Sand *2330-95*

Gas -----

Oil -----

Total Depth *2295'*

PRODUCTION

1st 24 hrs. Nat. -----

1st 24 hrs. after shot -----

Gas ----- Cu. Ft.

Dry Hole -----

Abandoned -----

Date

JUN 9 1926

CHAS. L. SHERWOOD

----- 192 ----- Scout