


Map No. X Sec. 27 Twp. 25 R. 9

Well No. Duncan Et al Farm Company

Ft. from N. Line
200 Ft. from S. Line
200 Ft. from E. Line
 Ft. from W. Line

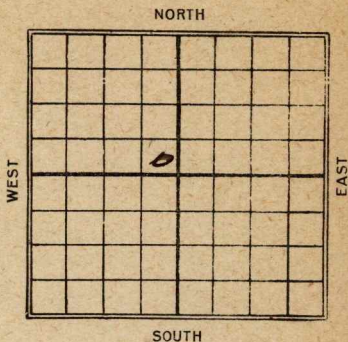

Date	REPORT
12/24	
6/24	Reg
7/16	LQ. 1700'
10/28	S.D. 2310
11/26	—
12/17	—
1925	—
1/21	—
3/1	Top Line 2410
	S. + G. 2470

15 KANSAS Map No. _____ Sec. 27 Twp. 25 R. 9

Well No. #1 _____

L. A. B. C. & Co. Company

_____ Contractor

FIRST REPORT

SECTION PLAT

	0		

_____ Ft. from N. Line

200 _____ Ft. from S. Line

200 _____ Ft. from E. Line

_____ Ft. from W. Line

Location _____

Rig up _____

Drilling and Remarks:

R. O. G.

RECORD

Cased _____ in., _____ ft.

Sand _____

Gas _____

Oil _____

Total Depth _____

PRODUCTION

1st 24 hrs. Nat. _____

1st 24 hrs. after shot _____

Gas _____ Cu. Ft.

• Dry Hole _____

Abandoned _____

Date

JUN 24 1924

M. A. BENEAR

192

Scout

Map No. 15 KANSAS Sec. 27 Twp. 25 R. 9Well No. 1 SallyardsL. O. O'Connell et al Company

Contractor

ABANDONED SECTION PLAT

-----Ft. from N. Line

200' Ft. from S. Line200' Ft. from E. Line

-----Ft. from W. Line

Location -----

Rig up -----

Drilling and Remarks:

Tap L. 2410
LO + 9 2470'

RECORD

Cased ----- in., ----- ft.

Sand -----

Gas -----

Oil -----

Total Depth -----

PRODUCTION

1st 24 hrs. Nat. -----

1st 24 hrs. after shot -----

Gas ----- Cu. Ft.

Dry Hole -----

Abandoned -----

Date

3/1 1925

M. A. BENEAR

Scout