


Granwood

Form 51-5M-2-29-34703

Map No. **KANSAS** Sec. *5* Twp. *24* R. *13*

Well No. *2-1-Sharp* Farm
Shuddy et al Company

NORTH

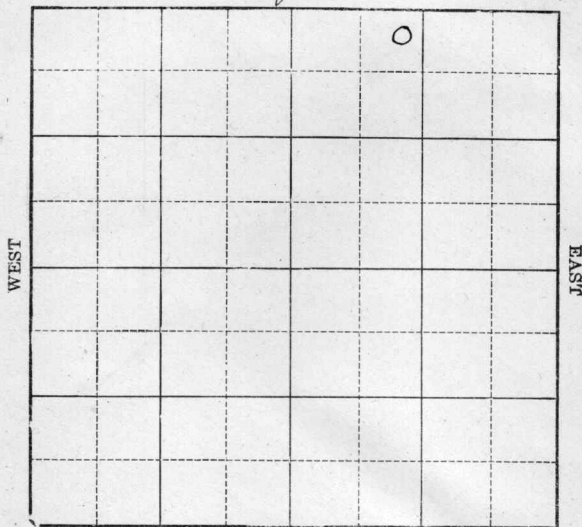

SOUTH

50' E gas well

Location

Drilling Remarks

Rig Up

Drilling Remarks

RECORD

Cased in. ft.

Sand

Gas

Oil

Total Depth

PRODUCTION

1st 24 hrs. Nat.

1st 24 hrs. after shot

Gas cu. ft.

Dry Hole

Abandoned

Map No. KANSAS Sec. 5 Twp. 24 R. 13


Well No. 2-Sharp Farm
Shedy et al Company

250 Ft. from N. Line

_____ Ft. from S. Line

_____ Ft. from E. Line

1200 Ft. from W. Line

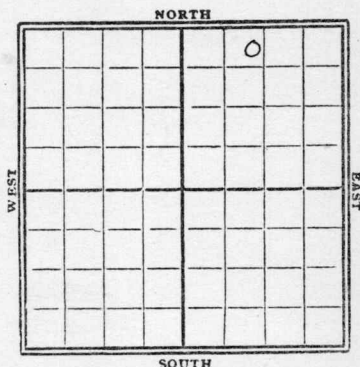

1929

Date

REPORT

50' east gas well

3/6 Top line - 1635'

sand 1645-61'

T.D. 1663'

shot 40 qts

45 bbl. oil

41° gravity
Pump

nomap
 Map No. **KANSAS** Sec. *5* Twp. *24* R. *13*

Well No. *2 Sharp.*
Sheedy et al Company

FIRST REPORTS

Contractor

COMPLETE

SECTION PLAT

		○	

250 Ft. from N. Line

Ft. from S. Line

Ft. from E. Line

1200 Ft. from W. Line

50' East Gas Well.

Location

Rig up

Drilling and Remarks:

top line 1635

40745 lbs.

41 gravity.

RECORD

Cased in, ft.

Sand *1645-1661*

Gas

Oil

Total Depth *1663*

PRODUCTION

1st 24 hrs. Nat.

1st 24 hrs. after shot

Gas Cu. Ft.

Dry Hole

Abandoned

Date

MAR 6 1929

192

CHAS. L. SHERWOOD

Scout