


Map No. KANSAS Sec. 5 Twp. 24 R. 13^E

Well No. 3-Sharp Farm Shedy et al Company

NORTH

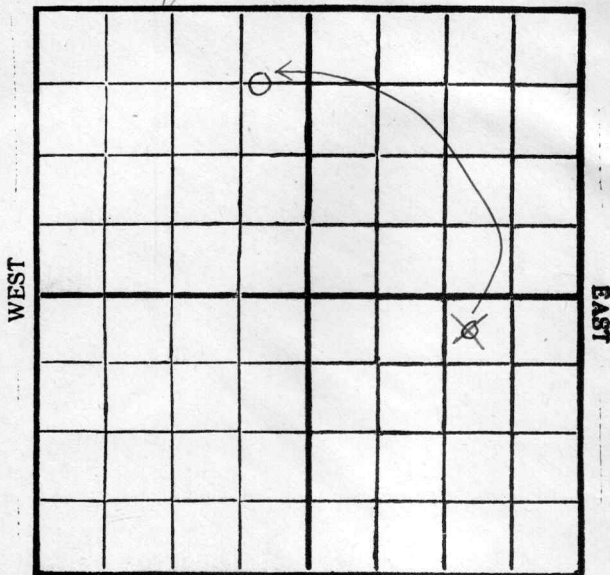

SOUTH

Location _____

Drilling Remarks _____

Rig Up _____

Drilling Remarks _____

RECORD

Cased _____ in. _____ ft.

Sand _____

Gas _____

Oil _____

Total Depth _____

PRODUCTION

1st 24 hrs. Nat. _____

1st 24 hrs. after shot _____

Gas _____ cu. ft.

Dry Hole _____

Abandoned _____

Map No. KANSAS Sec. 5 Twp. 24 R. 13^E
 Well No. 3-Sharp Farm
Sheddy et al Company

660

~~250~~

Ft. from N. Line


Ft. from S. Line

500

~~7070~~

Ft. from E. Line

Ft. from W. Line

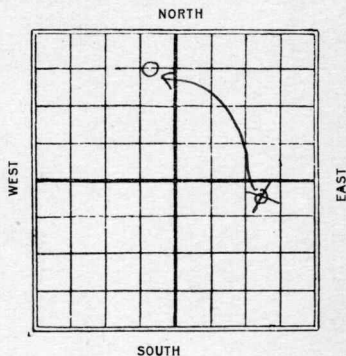

1929

Date

REPORT

Date	REPORT
10/16	Drly 400'
10/23	" 1000'
10/30	" 1480'
11/6	Tap line 1609'
	Oil 1617-30'
	T.D. 1636'
	shot 40 gts
	40 bbls oil
	Comp.

KANSAS

Map No. _____ Sec. 5 Twp. 74 R. 13^EWell No. 173 SharpSheedy et al Company

Contractor

FIRST REPORTS

SECTION PLAT

750 Ft. from N. Line

_____ Ft. from S. Line

1070 Ft. from E. Line

_____ Ft. from W. Line

			0

Location _____

Rig up by 400'

Drilling and Remarks:

RECORD

Cased _____ in., _____ ft.

Sand _____

Gas _____

Oil _____

Total Depth _____

PRODUCTION

1st 24 hrs. Nat. _____

1st 24 hrs. after shot _____

Gas _____ Cu. Ft.

Dry Hole _____

Abandoned _____

Date

OCT 16 1929

CHAS. L. SHERWOOD

192 _____ Scout

Greenwood

KANSAS

Map No. _____ Sec. 5 Twp. 74 R. 13Well No. 173 Sharp.Sheedy & Co Company

Contractor

CORRECTION


660 Ft. from N. Line

_____ Ft. from S. Line

500 Ft. from E. Line

_____ Ft. from W. Line

SECTION PLAT

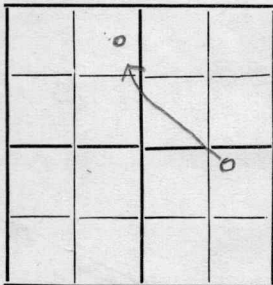

Location _____

Rig up by 1000

Drilling and Remarks:

chy location,

RECORD

Cased _____ in., _____ ft.

Sand _____

Gas _____

Oil _____

Total Depth _____

PRODUCTION

1st 24 hrs. Nat. _____

1st 24 hrs. after shot _____

Gas _____ Cu. Ft.

Dry Hole _____

Abandoned _____

Date

OCT 23 1929

CHAS. L. SHERWOOD

192

Scout

17 Map No. KANSAS Sec. 5 Twp. 74 R. 13

Well No. 3 Sharp.
Sheedy & Co Company

Contractor

COMPLETE

SECTION PLAT

660 Ft. from N. Line

_____ Ft. from S. Line

500 Ft. from E. Line

_____ Ft. from W. Line

	0		

Location _____

Rig up _____

Drilling and Remarks:

Tap line 1609

40/40 Bls.

RECORD

Cased _____ in., _____ ft.

Sand 1617-1630

Gas _____

Oil _____

Total Depth 1636

PRODUCTION

1st 24 hrs. Nat. _____

1st 24 hrs. after shot _____

Gas _____ Cu. Ft.

Dry Hole _____

Abandoned _____

Date

NOV 6 1929

CHAS. L. SHERWOOD

192

Scout