


Map No. *Kansas Greenwood* Sec. *30* Twp. *25* R. *9*

Well No. *8 Hoffman* Farm

Mid-Kansas Company

NORTH

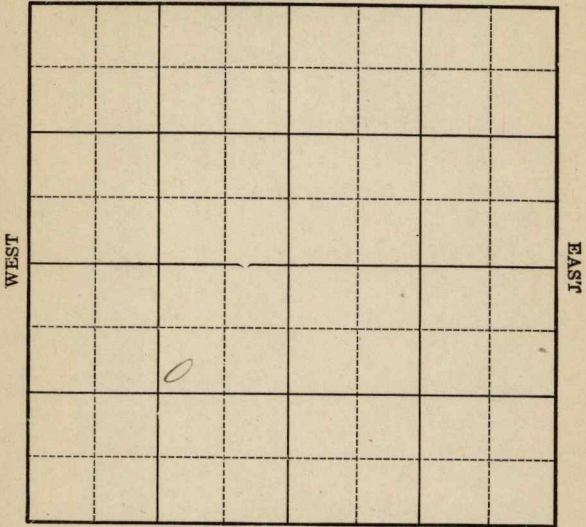

SOUTH

Location _____

Rig Up _____

Drilling Remarks _____

Drilling Remarks _____

RECORD

PRODUCTION

Cased _____ in. _____ ft.

1st 24 hrs. Nat. _____

Sand _____

1st 24 hrs. after shot _____

Gas _____

Gas _____ cu. ft.

Oil _____


Dry Hole _____

Total Depth _____

Abandoned _____

Map No. Kansas Greenwood
 Sec. 30 Twp. 25 R. 9
 Well No. 8 Hoffman Farm
Mid-Kansas Company

1297 Ft. from N. Line
 _____ Ft. from S. Line
1048 Ft. from E. Line
 _____ Ft. from W. Line

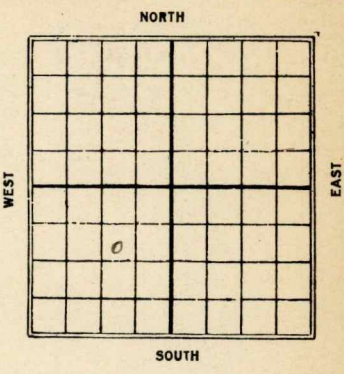

Date	REPORT
<u>1926</u>	
<u>5/26</u>	<u>Rig up</u>
<u>6/2</u>	<u>Same</u>
<u>6/10</u>	_____
<u>6/18</u>	_____
<u>6/25</u>	<u>Dlg 250</u>
<u>6-30</u>	<u>" 1000</u>
<u>7/8</u>	<u>" 1425</u>
<u>7/15</u>	<u>" 1750</u>
<u>7/22</u>	<u>" 2200</u>
<u>7/28</u>	<u>Sand 2413 - 2459.</u>
	<u>60/75 bbls. - T.D. 2463</u>

Greenwood

K15 KANSAS Sec. *30* Twp. *25* R. *9*

Well No. *8 Hoffmann*
Mid-Kansas Company

Contractor

FIRST REPORTS

SECTION PLAT

1297 Ft. from N. Line

Ft. from S. Line

1048 Ft. from E. Line

Ft. from W. Line

Location -----

Rig up -----

Drilling and Remarks:

RECORD

Cased ----- in., ----- ft.

Sand -----

Gas -----

Oil -----

Total Depth -----

PRODUCTION

1st 24 hrs. Nat. -----

1st 24 hrs. after shot -----

Gas ----- Cu. Ft.

Dry Hole -----

Abandoned -----

Date

MAY 26 1926

192

CHAS. L. SHERWOOD

Scout

Sherwood

Map No. K15 KANSAS Sec. 30 Twp. 25 R. 9

Well No. 8 Hoffman

Mid-Kansas Company

Contractor

COMPLETED

SECTION PLAT

1297 Ft. from N. Line

_____ Ft. from S. Line

1048 Ft. from E. Line

_____ Ft. from W. Line

	0		

Location _____

Rig up _____

Drilling and Remarks:

600
75 lbs.

RECORD

Cased _____ in., _____ ft.
 Sand 2413-2459
 Gas _____
 Oil _____
 Total Depth 2463

PRODUCTION

1st 24 hrs. Nat. _____
 1st 24 hrs. after shot _____
 Gas _____ Cu. Ft.
 Dry Hole _____
 Abandoned _____

Date
JUL 28 1926

CHAS. L. SHERWOOD