


Greenwood

Map No. *KAN* Sec. *30* Twp. *25* R. *9*
Well No. *9* *Goffman* Farm
Mid-Kansas Company

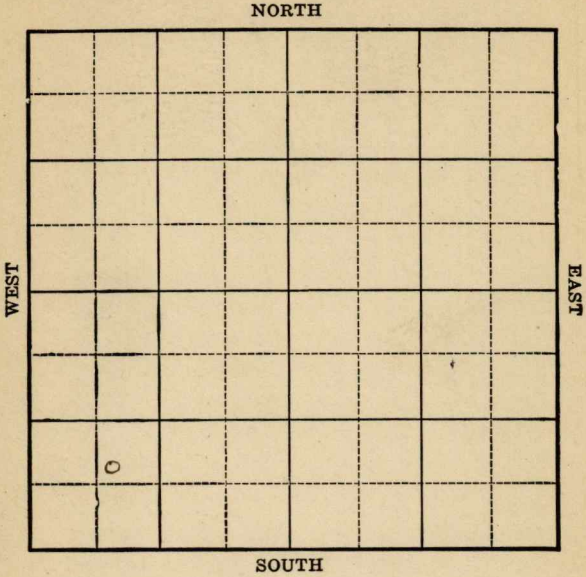

Location _____
Drilling Remarks _____

Rig Up _____
Drilling Remarks _____

RECORD

PRODUCTION

Cased _____ in. _____ ft.
Sand _____
Gas _____
Oil _____
Total Depth _____


1st 24 hrs. Nat. _____
1st 24 hrs. after shot _____
Gas _____ cu. ft.
Dry Hole _____
Abandoned _____

Map No. Kansas Sec. 30 Twp. 25 R. 9
 Well No. 9 Hoffman Farm
Mid-Kansas Company

NORTH

WEST

EAST

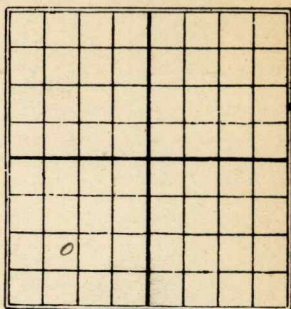

SOUTH

Ft. from N. Line

830 Ft. from S. Line

Ft. from E. Line

700 Ft. from W. Line

Date

REPORT

1926
8/18 Location

8/25 timbers

8-31 Ripping up

9/15 Dr lg 900

9/22 " 1200

9/29 same

10/13 S.D. 1800'

10/27 Sand 2382-2441
60/75 barrels

15 KANSAS 30 25 9
 Map No. Sec. Twp. R.

Well No. 9 Hoffmann
 Med. Kansas

Company

Contractor

FIRST REPORTS

SECTION PLAT

Ft. from N. Line

830

Ft. from S. Line

Ft. from E. Line

700

Ft. from W. Line

0			

Location ✓

Rig up

Drilling and Remarks:

RECORD

Cased in., ft.

Sand

Gas

Oil

Total Depth

PRODUCTION

1st 24 hrs. Nat.

1st 24 hrs. after shot

Gas Cu. Ft.

Dry Hole

Abandoned

Date

AUG 18 1926

192

CHAS. I. SHERWOOD

Scout

15 **KANSAS** Sec. 30 Twp. 25 R. 9

Well No. 9 Hoffmann
Mid-Kansas Company

Contractor

COMPLETED

SECTION PLAT

_____ Ft. from N. Line

830 _____ Ft. from S. Line

_____ Ft. from E. Line

700 _____ Ft. from W. Line

Location _____

Rig up _____

Drilling and Remarks:

69/75 B.S.

RECORD

Cased _____ in., _____ ft.

Sand 2382-2441

Gas _____

Oil _____

Total Depth 2441

PRODUCTION

1st 24 hrs. Nat. _____

1st 24 hrs. after shot _____

Gas _____ Cu. Ft.

Dry Hole _____

Abandoned _____

Date

OCT 27 1926

192

CHAS. L. SHERWOOD

Scout