


Map No. KANSAS Sec. 6 Twp. 24 R. 13^E
Well No. 1- Gassoway Farm
Walton Oil Co Company

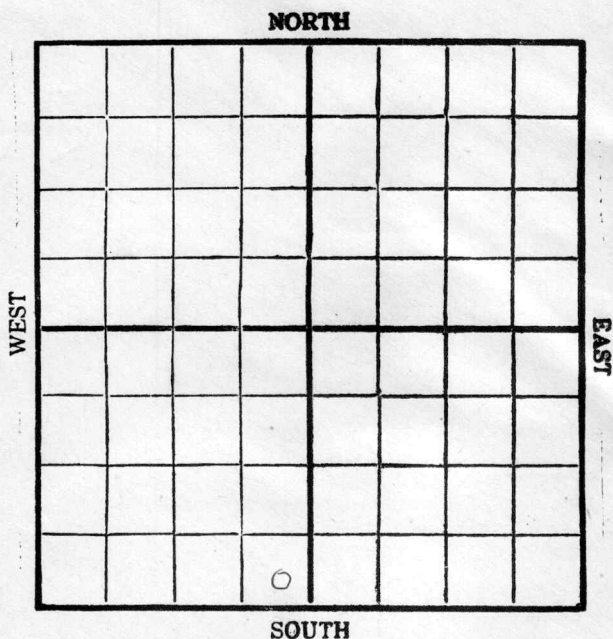

Location _____

Drilling Remarks _____

RECORD

Cased _____ in. _____ ft.

Sand _____

Gas _____

Oil _____

Total Depth _____

Rig Up _____

Drilling Remarks _____

PRODUCTION

1st 24 hrs. Nat. _____

1st 24 hrs. after shot _____

Gas _____ cu. ft. _____

Dry Hole _____

Abandoned _____

Map No. KANSAS Sec. 10 Twp. 24 R. 13

Well No. 1- Passaic Farm

Waltham 08271 Company


Ft. from N. Line

220 Ft. from S. Line

220 Ft. from E. Line

Ft. from W. Line

1929

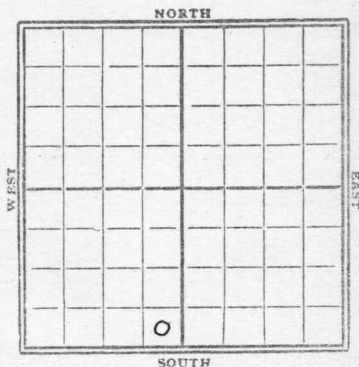

Date _____

REPORT

9/18 Machine

9/25 Spin up

0/2 | Q. A. d. y.

10/9 Wld 1160'

0116 Top Time, 1603'

July 1628

0/23 Top Line 1603-28'

75, T.D. 1628

P.B. to 1623

shot 20 gts
7 bbls oil and
15 " water
Soup.

Srnwood

Map No. **KANSAS** Sec. 6 Twp. 24 R. 13 ^EWell No. 1 GassawayWalton Oil Co Company

Contractor

FIRST REPORTS

SECTION PLAT

Ft. from N. Line

220 Ft. from S. Line220 Ft. from E. Line

Ft. from W. Line

Location Machino

Rig up

Drilling and Remarks:

RECORD

Cased _____ in., _____ ft.

Sand _____

Gas _____

Oil _____

Total Depth _____

PRODUCTION

1st 24 hrs. Nat. _____

1st 24 hrs. after shot _____

Gas _____ Cu. Ft.

Dry Hole _____

Abandoned _____

Date

SEP 18 1929

192

CHAS. L. SHERWOOD

Scout

Greenwood
 17 **KANSAS** Map No. _____ Sec. *6* Twp. *24* R. *13*

Well No. *Gasaway*
Walton Oil Co Company

Contractor

COMPLETE

SECTION PLAT

_____ Ft. from N. Line

270 Ft. from S. Line

270 Ft. from E. Line

_____ Ft. from W. Line

Location _____

Rig up _____

Drilling and Remarks:

Top line 1603-1628

FFS 1623'

20/7 BS oil
15 " water.

RECORD

Cased _____ in., _____ ft.

Sand _____

Gas _____

Oil _____

Total Depth *1628*

PRODUCTION

1st 24 hrs. Nat. _____

1st 24 hrs. after shot _____

Gas _____ Cu. Ft.

Dry Hole _____

Abandoned _____

Date

OCT 23 1929

CHAS. L. SHERWOOD

192

Scout