


Pratt

Section 24 Township 29 Range 14W

Well No. 2 Andrews "B"

Company Lion Oil Company

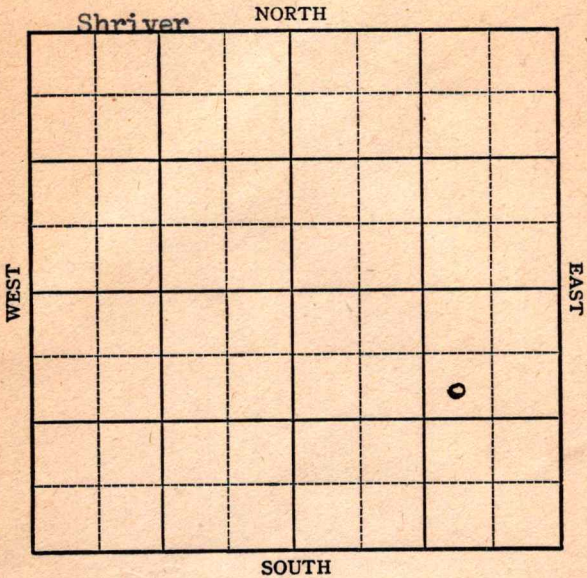

KANSAS

Pratt

Sec. 24 Twp. 29 R. 14-W

Well No. #2 Andrews "B" Farm

Lion Oil Company

Was a Carter lease)


990 Ft. from N. Line

Ft. from S. Line

990 Ft. from E. Line

Ft. from W. Line

SW NE SE

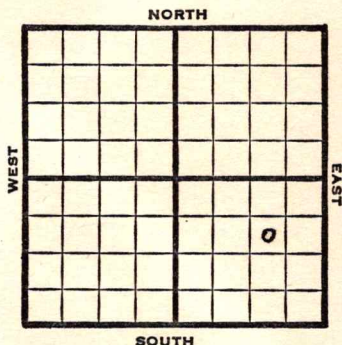

1947 **Elev. 1964'** REPORT

4/9 8" set 488' WOC

4/15 Drlg. 3070'

4/23 **Lans 3860**
Drlg 4085'

4/29 **Arb 4335**
TD 4369'
5" @ 4368'
RUST

5/7 " "

5/13 " "

5/21 **Arb 4335**
5" @ 4368'
Bonnet Pot 2866 oil & 3% W
Grav. 39.9
TD 4369'

COMPLETED

Map No. 1592 Sec. 24 Twp. 29 R. 14W


Well No. 2 Andrews "B"

Lion Oil Company

FIRST REPORT Contractor

SW NE SE

SECTION PLAT

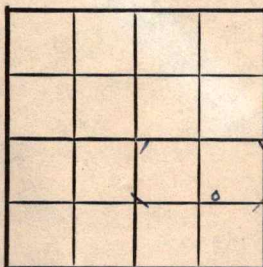

990 Ft. from N. Line

 Ft. from S. Line

990 Ft. from E. Line

 Ft. from W. Line

Pratt County

Location

Rig up

Drilling and Remarks:

Was a Carter
lease

8" @ 488 WOC

RECORD

Cased in., ft.

Sand

Gas

Oil

Total Depth

PRODUCTION

1st 24 hrs. Nat.

1st 24 hrs. after shot

Gas Cu. Ft.

Dry Hole

Abandoned

Date

APR 9 1947

19

S. J. LEWIS

Scout

Map No. 1592 Sec. 24 Twp. 29 R. 14W

Well No. 2 Andrews "B"

Lion Oil

Company

COMPLETE

Contractor

SW NE SE


E 11/1964
SECTION PLAT

990 Ft. from N. Line

_____ Ft. from S. Line

990 Ft. from E. Line

_____ Ft. from W. Line

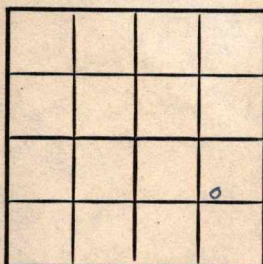

Pratt County

Location _____

Rig up _____

Drilling and Remarks:

Corr 4335

5' @ 4365

Barrel Prod 2866 oil

13% W

39 E 4

RECORD

Cased _____ in., _____ ft.

Sand _____

Gas _____

Oil _____

Total Depth 4369

PRODUCTION

1st 24 hrs. Nat. _____

1st 24 hrs. after shot _____

Gas _____ Cu. Ft.

Dry Hole _____

Abandoned _____

Date

MAY 21 1947 19

S. J. LEWIS

Scout