


Section 14 Township 29 Range 13-W

Well No. 1 Thornton

Company Luther Mackell et al

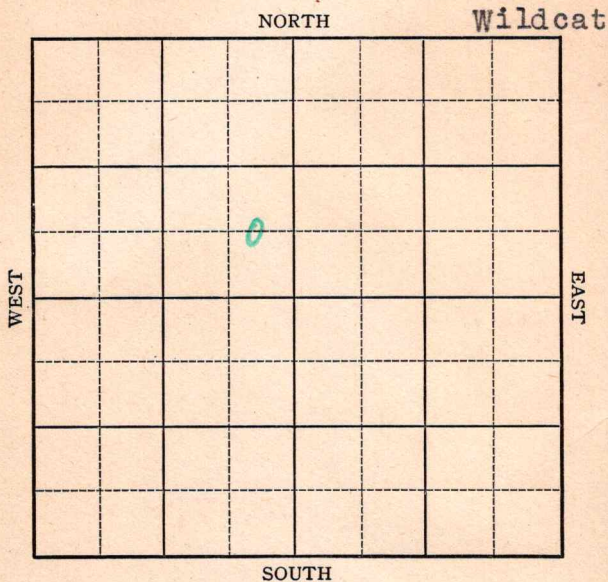

Sec. 14 Twp. 29 R. 13-W

Well No. #1 Thornton Farm

Luther Mackell et al Company


(Wildcat)

Ft. from N. Line

660 Ft. from S. Line

330 Ft. from E. Line

Ft. from W. Line

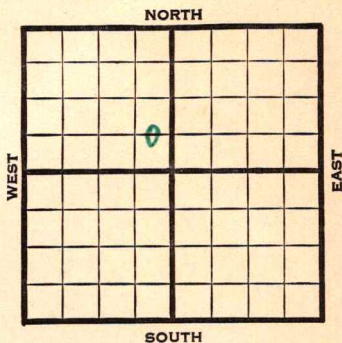

Elev. 1913

1941	REPORT
10/1	Anhy. 726'
	Drlg. 1000'
10/9	Drlg. 3280'
10/16	Topeka 2345' Lans. 3919'
	Drlg. 4097'
10/23	Viola 4518' Drlg. 4594'
10/30	Simp. 4635' Drlg. 4696'
11/5	Arb. 4735'
	T.D. 4777'
	No shows.
	ABANDONED

Map No. H-92 Sec. 14 Twp. 29 R. 13W

Well No. 1 Thornton

Luther Mackell etal Company

Contractor

FIRST REPORT

C E L S E N W

_____ Ft. from N. Line

660 Ft. from S. Line

330 Ft. from E. Line

_____ Ft. from W. Line

SECTION PLAT

WILDCAT

Location _____

Rig up _____

Drilling and Remarks:

Anhy. 726

Drilling 1000'

RECORD

Cased _____ in., _____ ft.

Sand _____

Gas _____

Oil _____

Total Depth _____

PRODUCTION

1st 24 hrs. Nat. _____

1st 24 hrs. after shot _____

Gas _____ Cu. Ft.

Dry Hole _____

Abandoned _____

Date

OCT 1 1941 19

S. J. LEWIS Scout

Map No. H-92 Sec. 14 Twp. 29 R. 13W

Well No. 1 Thornton

Luther Mackall et al. Company

ABANDONED Contractor

C EL SE NW

SECTION PLAT

 Ft. from N. Line

660 Ft. from S. Line

330 Ft. from E. Line

 Ft. from W. Line

		o	

WILDCA T

Location

Rig up

Drilling and Remarks:

Cor & 4735.

Nostrino.

RECORD

Cased in., ft.

Sand

Gas

Oil

Total Depth 4777

PRODUCTION

1st 24 hrs. Nat.

1st 24 hrs. after shot

Gas Cu. Ft.

Dry Hole

Abandoned

Date

NOV 5 1941 19

S. J. LEWIS

Scout