

Abandoned.....

Greenwood

FORM 252A-5M-12-28-PETROL

Map No. KANSAS Sec. 5 Twp. 24 R. 13

Well No. 3 - Sharp Farm


Shedey et al Company

660 Ft. from N. Line

_____ Ft. from S. Line

2640 Ft. from E. Line

_____ Ft. from W. Line

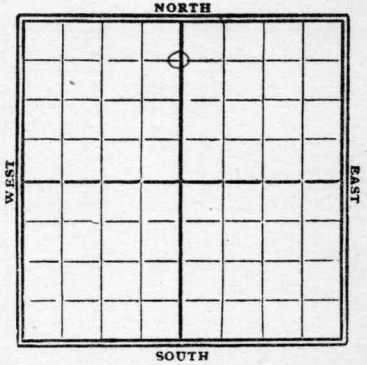

1929

Date

REPORT

7/2 Drilg 1600'
7/10 SID 1600'
7/17 Top line 1583'
sand 1597-1610'
T.D. 1614'
shot 40 gtr
225 bbl oil
Pump.

17 Map No. KANSAS Sec. 5 Twp. 24 R. 13

Well No. 3 Sharp.

Sheedy et al Company

Contractor

FIRST REPORTS


660 Ft. from N. Line

_____ Ft. from S. Line

7640 Ft. from E. Line

7640 Ft. from W. Line

SECTION PLAT

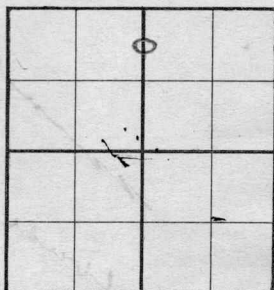

Location _____

Rig up _____

Drilling and Remarks:

By 1600'

RECORD

Cased _____ in., _____ ft.

Sand _____

Gas _____

Oil _____

Total Depth _____

PRODUCTION

1st 24 hrs. Nat. _____

1st 24 hrs. after shot _____

Gas _____ Cu. Ft.

Dry Hole _____

Abandoned _____

Date

7/2

CHAS. L. SHERWOOD

1929

Scout

17 **KANSAS** Sec. 5 Twp. 24 R. 13

Well No. 3 Sharp

Sheedy & Co. Company

Contractor

COMPLETE

SECTION PLAT

660 Ft. from N. Line

_____ Ft. from S. Line

_____ Ft. from E. Line

2640 Ft. from W. Line

		①	

Location _____

Rig up _____

Drilling and Remarks:

T. Lime 1583'

40/225 Bls.

RECORD

Cased _____ in., _____ ft.

Sand 1597-1610

Gas _____

Oil _____

Total Depth 1614'

PRODUCTION

1st 24 hrs. Nat. _____

1st 24 hrs. after shot _____

Gas _____ Cu. Ft.

Dry Hole _____

Abandoned _____

Date

JUL 17 1929

CHAS. L. SHERWOOD

19

Scout