


Map No. KANSAS Sec. 5 Twp. 24 R. 13^E
 Well No. 4 - Sharp Farm _____
Sheedy et al Company _____

NORTH

WEST

EAST

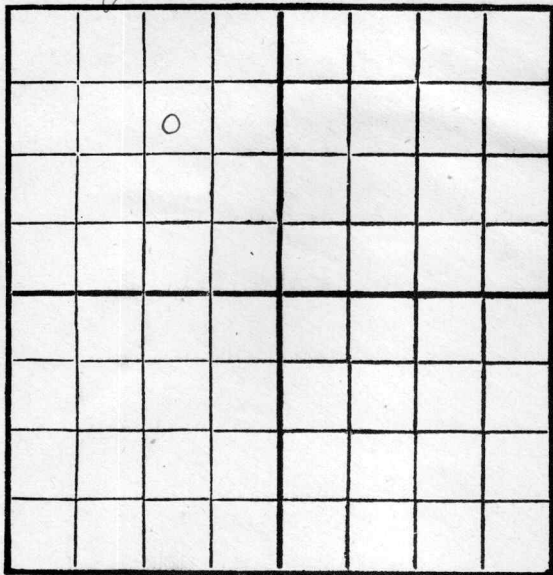

SOUTH

Location _____

Drilling Remarks _____

Rig Up _____

Drilling Remarks _____

RECORD

Cased _____ in. _____ ft.

Sand _____

Gas _____

Oil _____

Total Depth _____

PRODUCTION

1st 24 hrs. Nat. _____

1st 24 hrs. after shot _____

Gas _____ cu. ft. _____

Dry Hole _____

Abandoned _____


Map No. 7 Sec. 5 Twp. 24 R. 13^E
Well No. 4 Sharp Farm
Shedy et al Company

1120 Ft. from N. Line

_____ Ft. from S. Line

1120 Ft. from E. Line

_____ Ft. from W. Line

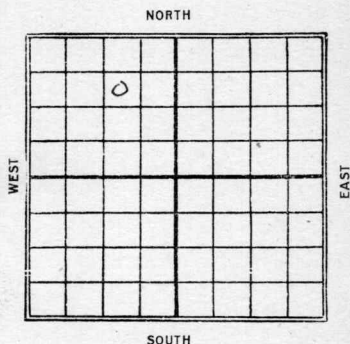

1929

Date REPORT

Date	REPORT
10/23	Rig up
10/30	
11/6	Drlg 1000'
11/13	Top line 1621'
	Pay 1627-36' T.D.
	shot 20 gts - H Foil
11/20	T.D. 1636'
	300 bbl 1 st 24 hrs.
11/28	Top line 1621'
	Pay 1627-36'
	T.D. 1636'
	shot 20 gts
	300 bbls oil
	Somp.

17 KANSAS

Greenwood

Map No. _____ Sec. 5 Twp. 24 R. 13^E

Well No. 4 Sharp.

Sheedy & Co

Company

Contractor

FIRST REPORTS

SECTION PLAT

1170 Ft. from N. Line

_____ Ft. from S. Line

1170 Ft. from E. Line

_____ Ft. from W. Line

	o		

Location _____

Rig up Rign up.

Drilling and Remarks _____

RECORD

Cased _____ in., _____ ft.

Sand _____

Gas _____

Oil _____

Total Depth _____

PRODUCTION

1st 24 hrs. Nat. _____

1st 24 hrs. after shot _____

Gas _____ Cu. Ft.

Dry Hole _____

Abandoned _____

Date

OCT 23 1929

CHAS. L. SHERWOOD

19

Scout

Greenwood
 Map No. *17* **KANSAS** Sec. *5* Twp. *24* R. *13*

Well No. *4* *Sharp*
Sheedy *Verbal* Company

Contractor

COMPLETE

SECTION PLAT

	0		

1120 Ft. from N. Line

Ft. from S. Line

1120 Ft. from E. Line

Ft. from W. Line

Location

Rig up

Drilling and Remarks:

Log line 1621

20/300 Bls.

RECORD

Cased in., ft.

Sand *1627-1636*

Gas

Oil

Total Depth *1636*

PRODUCTION

1st 24 hrs. Nat.

1st 24 hrs. after shot

Gas Cu. Ft.

Dry Hole

Abandoned

Date

11/28/29 192 **CHAS. L. SHERWOOD** Scout