

Well No. 2 Jadd Farm

Mid-Kansas Company

NORTH


SOUTH

COPIES REPORT
FIRST REPORT
COMPLETED

Rig Up _____

Drilling Remarks:

PRODUCTION

1st 24 hrs. Nat.

1st 24 hrs. after shot

Gas cu ft

Dry Hole

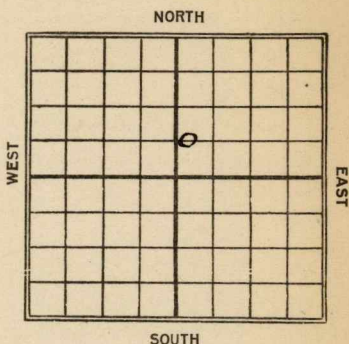
Abandoned

Map No. K. Sec. 30 Twp. 25 R. 9Well No. 2 Sadd FarmMid-Kansas Company

_____ Ft. from N. Line

660 Ft. from S. Line

_____ Ft. from E. Line

200 Ft. from W. LineDate
1922

REPORT

8/19 Location.
11/24 Sand 2442-2508 - Shot
40 gts. 100 Bbls.

Map No. K15 Sec. 30 Twp. 25 R. 9Well No. 2 LaddMid-Kansas Company

Contractor

FIRST REPORT

SECTION PLAT

Ft. from N. Line

660 Ft. from S. Line

Ft. from E. Line

200 Ft. from W. Line

		0	

Location ✓✓

Rig up

Drilling and Remarks:

RECORD

Cased in., ft.

Sand

Gas

Oil

Total Depth

PRODUCTION

1st 24 hrs. Nat.

1st 24 hrs. after shot

Gas Cu. Ft.

Dry Hole

Abandoned

Date

AUG 19 1922

191

M. A. BENEAR

Scou

Map No. **KANSAS** ¹⁵ Sec. **30** Twp. **25** R. **9**Well No. **2 Ladd**
Mid-Kansas Company

Contractor

COMPLETED

SECTION PLAT

Ft. from N. Line

660 Ft. from S. Line

Ft. from E. Line

200 Ft. from W. Line

		0	

Location -----

Rig up -----

Drilling and Remarks:

shot 40 ft

RECORD

Cased ----- in., ----- ft.

Sand -----

Gas -----

Oil **2442-2508**Total Depth **2508**

PRODUCTION

1st 24 hrs. Nat. -----

1st 24 hrs. after shot **100**

Gas ----- Cu. Ft.

Dry Hole -----

Abandoned -----

Date

NOV 24 1922

191

M. A. BENEAR

Scout