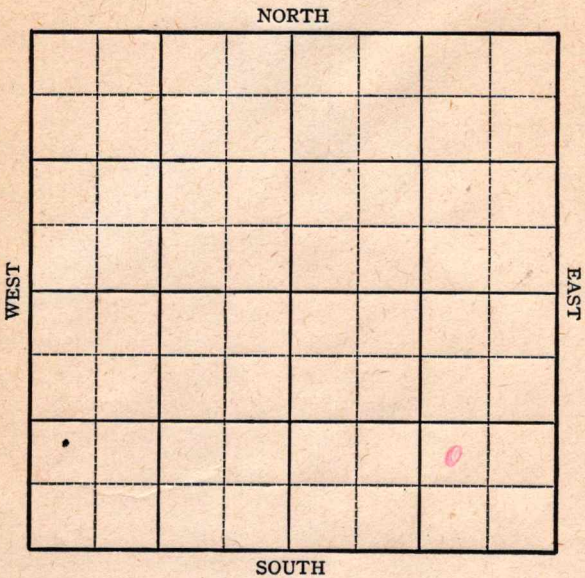


Section 24 Township 29 Range 14WWell No. 3 AndrewsCompany Lion Oil

KANSAS

Pratt

Sec. 24 Twp. 29 R. 14-W

Well No. #3 Andrews Farm


Lion Oil Company

 Ft. from N. Line

990 Ft. from S. Line

990 Ft. from E. Line

 Ft. from W. Line

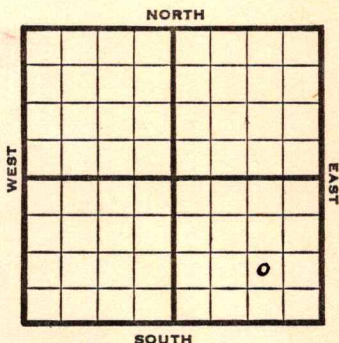

NW SE SE

SOUTH

1945

Elev. 1959

REPORT

9/19

Derrick

9/26

RUR

10/3

9" @ 478

10/10

Drlg. 1111'

10/17

Drlg. 2685'

10/24

Drlg. 3725

10/31

Drlg. 4239

11/7

Drlg. 4370

Arb. 4298

TD 4435

5" @ 4434

72 shots 4378-4390

1000 acid.

Flow 35 oil 1 hr.

11/14

" " " "

11/21

" " " "

11/28

Arb. 4298

5" @ 4434

TD 4435

Perf. Arb.

Bomb Pot. 3356

Max. 3000

Grav. 43.0

COMPLETED

KANSASKansas Pool Name ShriverMap No. 92 Sec. 24 Twp. 29 R. 14WWell No. 3 AndrewsLion Oil

Company

FIRST REPORT

Contractor

NW SE SE

SECTION PLAT

			0

Ft. from N. Line990Ft. from S. Line990Ft. from E. LineFt. from W. Line

Pratt County

RECORD

Location _____

Cased _____ in., _____ ft.

Rig up _____

Sand _____

Drilling and Remarks:

Gas _____

derrick

Oil _____

Total Depth _____

PRODUCTION

1st 24 hrs. Nat. _____

1st 24 hrs. after shot _____

Gas _____ Cu. Ft.

Dry Hole _____

Abandoned _____

Date

SEP 1 9 1945

19

S. J. LEWIS

Scout

KANSASPool Name ShriverMap No. 92 Sec. 24 Twp. 29 R. 14WWell No. 3 Andrews

Lion Oil _____ Company

COMPLETED

Contractor

NW SE SE

E 1/1909
SECTION PLAT

			6

_____ Ft. from N. Line

990 Ft. from S. Line990 Ft. from E. Line

_____ Ft. from W. Line

Pratt County

Location _____

Rig up _____

Drilling and Remarks:


Cased _____ in., _____ ft.

Sand _____

Gas _____

Oil _____

Total Depth 4435**PRODUCTION**

1st 24 hrs. Nat. _____

1st 24 hrs. after shot _____

Gas _____ Cu. Ft.

Dry Hole _____

Abandoned _____

Date

NOV 28 1945

19

S. J. LEWIS Scout