


Well No. 1 Hawk Farm

Roans Eval Company

NORTH

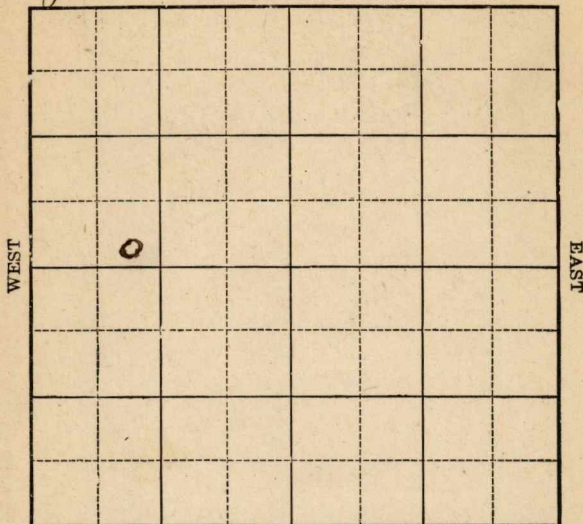

SOUTH

FIRST REPORT

Rig Up **COMPLETED**

Drilling Remarks:

PRODUCTION

1st 24 hrs. Nat. _____

1st 24 hrs. after shot_____

Gas _____ cu. ft.

Dry Hole _____

Abandoned _____

Map No. Kan 14 35 Sec. 25 Twp. 25 R. 10
 Well No. 1 Hawk
Rogers et al Company
 Contractor

FIRST REPORT

SECTION PLAT

_____ Ft. from N. Line

200 Ft. from S. Line

_____ Ft. from E. Line

810 Ft. from W. Line

Location _____

Rig up _____

Drilling and Remarks:

Rig

8/9 11.400

RECORD

Cased _____ in., _____ ft.

Sand _____

Gas _____

Oil _____

Total Depth _____

PRODUCTION

1st 24 hrs. Nat. _____

1st 24 hrs. after shot _____

Gas _____ Cu. Ft.

Dry Hole _____

Abandoned _____

Date

AUG 13 1922

191

M. A. BENEAR

Sc

Map No. **KANSAS** 16 Sec. **36** Twp. **25** R. **10**Well No. **1 - Hauck****Rogers et al** Company

Contractor

SECTION PLAT

ABANDONED

Ft. from N. Line

200 Ft. from S. Line

Ft. from E. Line

810 Ft. from W. Line

Location

Rig up

Drilling and Remarks:

RECORD

Cased _____ in., _____ ft.

Sand _____

Gas _____

Oil _____

Total Depth _____

PRODUCTION

1st 24 hrs. Nat. _____

1st 24 hrs. after shot _____

Gas _____ Cu. Ft.

Dry Hole **55** _____Abandoned **2080** _____

Date

SEP 16 1922

191

M. A. BENEAR

Scout