


Kansas

Map No. _____ Sec. *35* Twp. *25* R. *10*

Well No. *1 Sample* Farm _____

Bitler Eval Company _____

NORTH

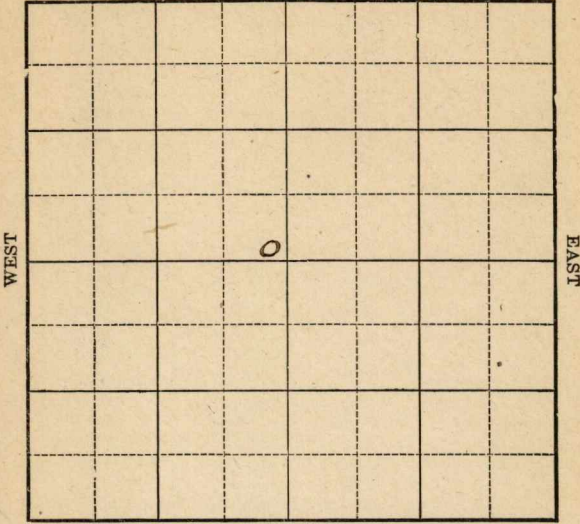

Location _____

Rig Up _____

Drilling Remarks:

Drilling Remarks:

RECORD

PRODUCTION

Cased _____ in. _____ ft.

1st 24 hrs. Nat. _____

Sand _____

1st 24 hrs. after shot _____

Gas _____

Gas _____ cu. ft.

Oil _____

Dry Hole _____

Total Depth _____

Abandoned _____

Map No. 16 Twp Sec. 35 Twp. 25 R. 10

Well No. 1 Sample
Bitler et al Company

Contractor

FIRST REPORT

----- Ft. from N. Line
200 Ft. from S. Line
200 Ft. from E. Line
----- Ft. from W. Line

SECTION PLAT

| | | | |
|--|--|--|--|
| | | | |
| | | | |
| | | | |
| | | | |

RECORD

Location -----
Rig up -----
Drilling and Remarks:

Cased ----- in., ----- ft.
Sand -----
Gas -----
Oil -----
Total Depth -----

spudding

PRODUCTION

1st 24 hrs. Nat. -----
1st 24 hrs. after shot -----
Gas ----- Cu. Ft.
Dry Hole ----- -----
Abandoned -----

Date

MAY 21 1922

M. A. BENEAR

191

Scout

Map No. Kans 14 35 Sec. 35 Twp. 25 R. 10

Well No. 1 Sample
Bittler et al. Company _____

Contractor _____

COMPLETED

SECTION PLAT

| | | | |
|--|--|---|--|
| | | | |
| | | 0 | |
| | | | |
| | | | |

_____ Ft. from N. Line

200' Ft. from S. Line

200' Ft. from E. Line

_____ Ft. from W. Line

Location _____

Rig up _____

Drilling and Remarks:

2. 1963-1990' TD.
in 1971-1990
plug back to 1996

RECORD

Cased _____ in., _____ f

Sand _____

Gas _____

Oil _____

Total Depth 2001

PRODUCTION

1st 24 hrs. Nat. 200H

1st 24 hrs. after shot _____

Gas _____ Cu. F

Dry Hole _____

Abandoned _____

Date

JUL 22 1922 191

M. A. BENEAR

Scou