

Kiowa

KANSAS

SECTION 33 TOWNSHIP 29 RANGE 19 W

WELL NO. #1 Wykle

COMPANY Bachus Oil (Bill Cecil)

NORTH

WEST

EAST

0

SOUTH

Kiowa

KANSAS

SEC.	TWP.	R.
33	29	19 W

WELL NO.

#1 Wykle

FARM

COMPANY

Bachus Oil (Bill Cecil)

CONTRACTOR

Aylward

WILDCAT


_____ Ft. from N. Line

_____ Ft. from S. Line

_____ Ft. from E. Line

_____ Ft. from W. Line

SW SW SE

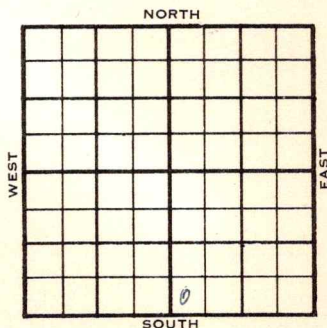

Amerada & Skelly DHM

	ELEVATION	REPORT
1956		
1-18	Location	

County

~~Kiowa~~

Elev.

Sec.

33

Twp.

29

Rge.

19W

Company

~~Bachus Oil~~

(Bill Cecil)

Farm Name

~~Wykle~~

No.

1

TOPS

DEPTH

LOG

DATUM

Loc. in Sec.

Anh.

Tp.

H.

Tr.

Dg.

Bl.

L.

K.C.

B.K.C.

Ce.

C.

M.

M.

K.

Mz.

Mq.

V.

S.

S.

A.

R.

Pe.

G.

T.D.

SW SW SE

Geol.

Contr.

Aylward

Pool

Wildcat

FIRST REPORT

JAN 8 1955

C

Date Comm.

Amerada & Skelly DHM

Location

~~25~~

