


Map No. KANSAS Sec. 6 Twp. 24 R. 13
Well No. 15 Nixon Farm
Walton Oil Company

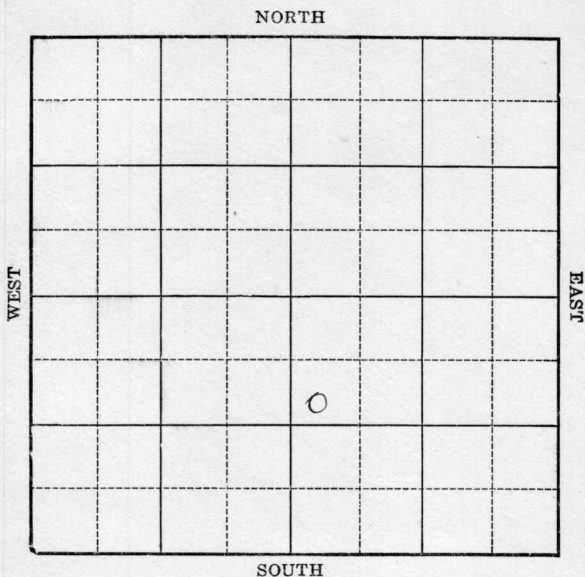

Location _____
Drilling Remarks _____

Rig Up _____
Drilling Remarks _____

RECORD

Cased _____ in. _____ ft.
Sand _____
Gas _____
Oil _____
Total Depth _____

PRODUCTION

1st 24 hrs. Nat. _____
1st 24 hrs. after shot _____
Gas _____ cu. ft.
Dry Hole _____
Abandoned _____

Greenwood

Map No. KANSAS Sec. 6 Twp. 24 R. 13E

Well No. 1- Nixon Farm


Walton Oil Company

NORTH

WEST

EAST

SOUTH

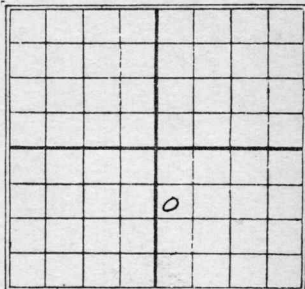

1120 Ft. from N. Line

_____ Ft. from S. Line

_____ Ft. from E. Line

200 Ft. from W. Line

1930

Date

REPORT

4/2	Drill 1065'
4/9	Top Line 1600' oil 1600-09' Slot 40 gts - small showing
4/16	Top line 1600 Pay 1600-09 TD 1609 shot 40 qt 40 bbl oil and 20 "water Pump

Greenwood

KANSAS

Map No. 17 Sec. 6 Twp. 24 R. 13 ^E

Well No. 1 Nixon

Walton Oil Co Company

Contractor

FIRST REPORTS

1120 Ft. from N. Line

..... Ft. from S. Line

..... Ft. from E. Line

700 Ft. from W. Line

SECTION PLAT

		0	

Location.....

Rig up.....

Drilling and Remarks:

by 1065'

RECORD

Cased.....in.,ft.

Sand.....

Gas.....

Oil.....

Total Depth.....

PRODUCTION

1st 24 hrs. Nat.....

1st 24 hrs. after shot.....

Gas.....Cu. Ft.

Dry Hole.....

Abandoned.....

Date

APR 2 1930

192.....

CHAS. L. SHERWOOD

Scout

Greenwood

Map No. **KANSAS** Sec. 6 Twp. 24 R. 13Well No. 17 Nixon
Waltom oil Co Company

Contractor

COMPLETE

SECTION PLAT

		0	

1120 Ft. from N. Line

Ft. from S. Line

Ft. from E. Line

200 Ft. from W. Line

Location

Rig up

Drilling and Remarks:

Top line 1600
40/40 Bb oil
20 " water.

RECORD

Cased _____ in., _____ ft.

Sand 1600-1609

Gas _____

Oil _____

Total Depth 1609

PRODUCTION

1st 24 hrs. Nat. _____

1st 24 hrs. after shot _____

Gas _____ Cu. Ft.

Dry Hole _____

Abandoned _____

Date

APR 16 1930

192 CHAS. L. SHERWOOD

Scout