


KANSAS

Section 6- Township 29 Range 10W

Well No. 1 Allbritten

Company Phil-Han etal.

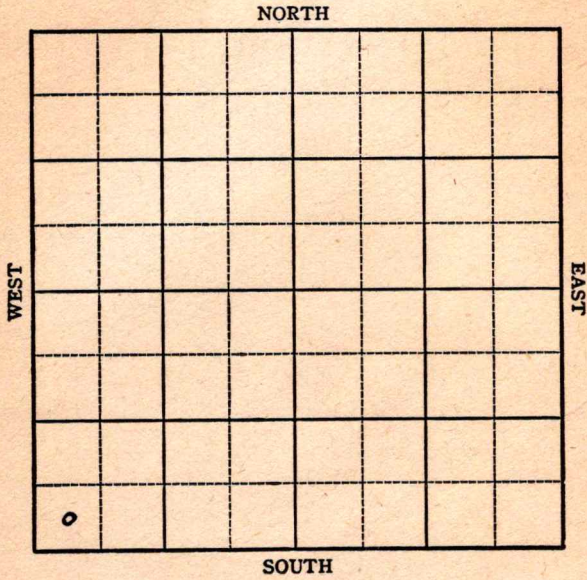

KANSAS

Kingman

Sec. 6 Twp. 29 R. 10-W

Well No. #1 Allbritten Farm


Phil-Han etal Company
Wildcat

Ft. from N. Line

330 Ft. from S. Line

Ft. from E. Line

330 Ft. from W. Line

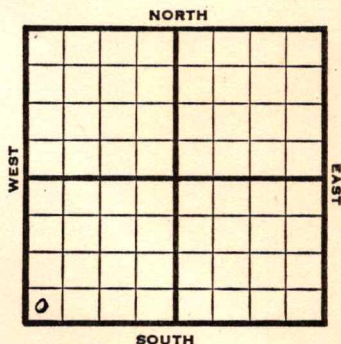

SW/C Elev. 1793'

REPORT

1947

3/5 Location

3/11 "

3/18 RUR

3/25 8" @ 285'
Drlg 2530'

4/2 **Lansing 3745'**
Drlg. 3800'

4/9 **Mississippi 4291'**
Drlg. 4343'

4612
1793
2819

4/16 **Viola 4535'**
Simp 4612
Arb 4693
TD 4712'

ABANDONED


Kansas **KANSAS**

Wildcat

Map No. 54 Sec. 6- Twp. 29 R. 10WWell No. 1 AllbrittenPhil-Han etal. Company**FIRST REPORT**

Contractor

SW/C

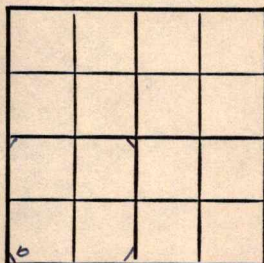SECTION PLAT Ft. from N. Line330 Ft. from S. Line Ft. from E. Line330 Ft. from W. LineKingman CountyLocation XRig up

Drilling and Remarks:

RECORDCased in., ft.Sand Gas Oil Total Depth **PRODUCTION**1st 24 hrs. Nat. 1st 24 hrs. after shot Gas Cu. Ft.Dry Hole Abandoned

Date

MAR 5 1947 19S. J. LEWIS Scout

Kansas


KANSAS

Map No. K54 Sec. 6 Twp. 29 R. 10WWell No. 1 AllbrittenPhil-Han et al. Company

ABANDONED

Contractor

SW/C

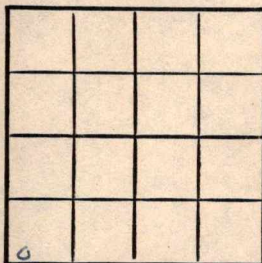E11793
SECTION PLAT Ft. from N. Line330 Ft. from S. Line Ft. from E. Line330 Ft. from W. Line

Kingman County

Location Rig up

Drilling and Remarks:

Viola 4585Scout 4612Scout 4693

RECORD

Cased in., ft.Sand Gas Oil Total Depth 4212

PRODUCTION

1st 24 hrs. Nat. 1st 24 hrs. after shot Gas Cu. Ft.Dry Hole Abandoned

Date

APR 16 1947 19

S. J. LEWIS Scout