
DX 78-1 Kingman

KANSAS

Section 36 Township 29 Range 9W

Well No. #1 Hartshorn "B"

Company Rupp-Ferguson

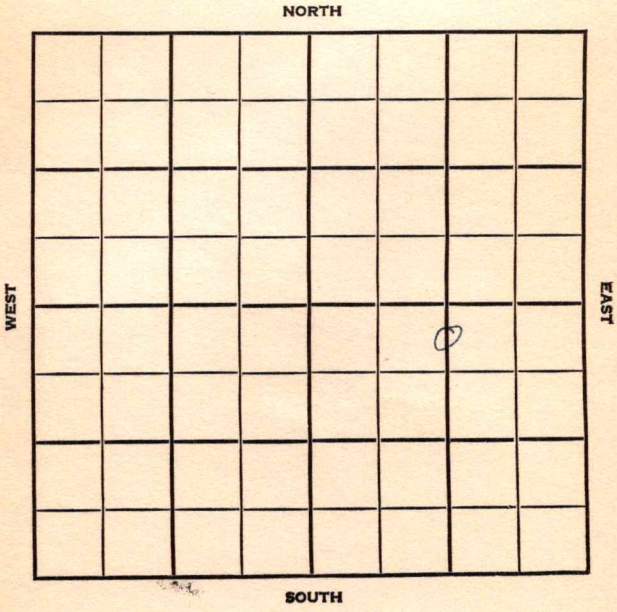

Kingman KANSAS

SEC.	TWP.	R.
36	29	9W

WELL NO.

#1 Hartshorn "B" FARM


COMPANY

Rupp - Ferguson

CONTRACTOR

Co. Tools

WILDCAT

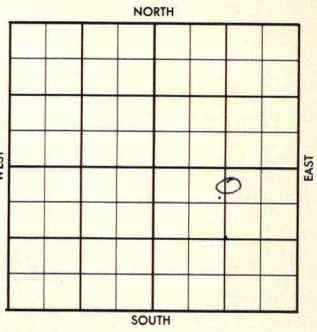

_____ FT. FROM N. LINE

_____ FT. FROM S. LINE

_____ FT. FROM E. LINE

_____ FT. FROM W. LINE

C N½ N½ SE

SDX - 3/4 mile Phillips - FO

	ELEVATION	
1956	1625'	REPORT

8-8 Loc.

8-13 Spud 8-6-56
8 5/8" @ 243 w/200
Heeb. 3312'; Doug. 3373';
Drlg. 3543'

8-22 DST 4241-95 op 30 min. rec. 20' mud, All press. 0#.
D&A
H. 3312'; Dg. 3373'; L. 3533';
BKC 4002'; M. 4240';
Log tops:
H. 3308'; Tr. 3324'; Dg. 3358';
Dg. sd. 3372'; L. 3532'; BKC 4002';
Marm 4026'; M. 4240';
TD 4292'

ABANDONED

FORM 504-5 SUNRAY

FORM 513 SUNRAY

County Kingman Elev.

Sec. 36 Twp. 29 Rge. 9W

Company Rupp-Ferguson

Farm Name Hartshorn "B" No. 1

TOPS	DEPTH	LOG	DATUM
Anh.			
Tp.			
H.			
Tr.			
Dg.			
Bl.			
L.			
K.C.			
B.K.C.			
Ce.			
C.			
M.			
M.			
K.			
Mz.			
Mo.			
V.			
S.			
S.			
A			
R.			
P€.			
G.			
T.D.			

Loc. in Sec. C N½ N½ SE

Geol.

Contr. Co. tools

Pool Wildcat

3/4 mile

FIRST REPORT

AUG 8 '56

Date Comm. Phillips - FO

Location

AUG 16 1956

R. C.

27

Co. Lse. No. Sec. T. R.

FORM 513 SUNRAY

County Kingman Elev. 1625

Sec. 36 Twp. 29 Rge. 9W

Company Rupp-Ferguson

Farm Name Hartshorn "B" No. 1

	DEPTH	LOG	DATUM
H.	3312	3308	
Tr.		3324	
Dg.	3373	3358	
Bl. Dgzd		3372	
L.	3533	3532	
K.C.			
B.K.C.	4002	4002	
Ce. Marm		4026	
C.			
M.	4240	4240	
M.			
K.			
Mz.			
Mo.			
V.			
S.			
S.			
A			
R.			
P€.			
G.			
T.D.	4291	4293	

Loc. in Sec. C N½ N½ SE

Geol.

Contr. Co. tools

Pool Wildcat

ABANDONED

¼ mile

AUG 22 1956

Date Comm. Phillips - FO

Location

AUG 15 '56

8-6-56 8 5/8 @ 243/200

TD 3543 AUG 22 '56 DST 4241-55' open 30" rec 20' Md All press O

DEA

Co. Lse. No. Sec. T. R.