


Kingman KANSAS

FORM 51 10M 12-46 PETROL

Section 30 Township 29 Range 10W

Well No. 1 Cirkel

Company Globe et al
Wildcat

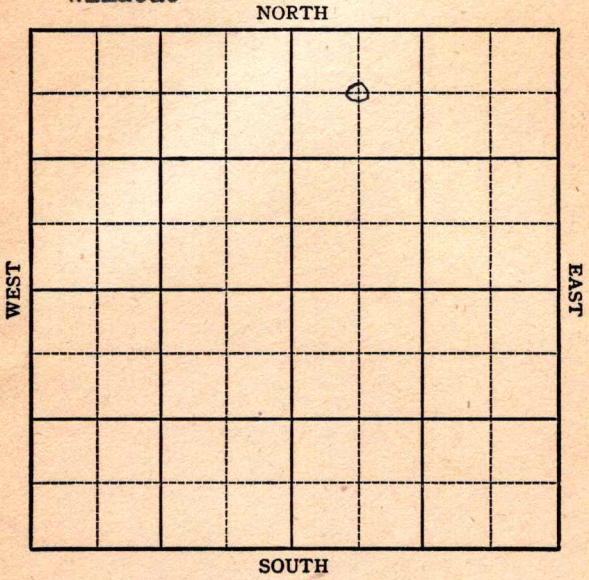

KANSAS Kingman ✓

Sec. 30 Twp. 29 R. 10W

Well No. #1 Cirkel Farm

Globe et al Company

Wildcat


660 Ft. from N. Line

Ft. from S. Line

Ft. from E. Line

660 Ft. from W. Line

C NW NE

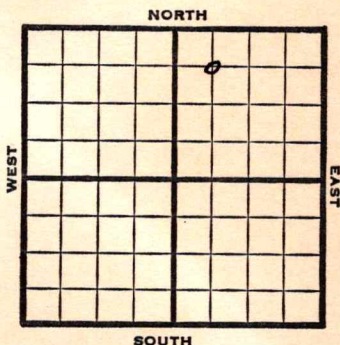

1947

Elev. 1745

REPORT

4/2 Location.

4/9 "

4/15 Drlg. 2770'

4/23 **Lans 3746**
Drlg 4170'

4622
1745

2877

4/30 **Miss 4282**
Viola 4550
Simp 4622
Arb 4723
TD 4758'

ABANDONED

Map No. 554 Sec. 30 Twp. 29 R. 10W


Well No. 1 Cirkel

Globe etal. Company

FIRST REPORT Contractor

C NW NE

SECTION PLAT

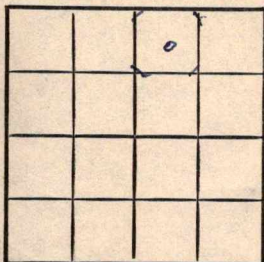

660 Ft. from N. Line

 Ft. from S. Line

 Ft. from E. Line

660 Ft. from W. Line

Kingman County

Location X

Rig up

Drilling and Remarks:

RECORD

Cased in., ft.

Sand

Gas

Oil

Total Depth

PRODUCTION

1st 24 hrs. Nat.

1st 24 hrs. after shot

Gas Cu. Ft.

Dry Hole

Abandoned

Date

APR 2 1947 19

S. J. LEWIS Scout

Map No. 54 Sec. 30 Twp. 29 R. 10WWell No. 1 CirkelGlobe etal. CompanyABANDONED

Contractor

C NW NE

21, 1945

SECTION PLAT

660 Ft. from N. Line Ft. from S. Line Ft. from E. Line660 Ft. from W. Line

		<u>6</u>	

Kingman CountyLocation Rig up

Drilling and Remarks:

Miss 4252Vol 4550Sing 4622Cr 4728

RECORD

Cased in., ft.Sand Gas Oil Total Depth 4758

PRODUCTION

1st 24 hrs. Nat. 1st 24 hrs. after shot Gas Cu. Ft.Dry Hole Abandoned

Date

APR 30 1947 19 S. J. LEWIS Scout