

Dup

Map No. *K* Sec. *18* Twp. *25* R. *9*

Well No. *1* *Hendrickson* Farm

Morgan et al Company

NORTH

WEST

EAST

SOUTH

Location _____

Drilling Remarks:

Rig Up _____

Drilling Remarks:

RECORD

Cased _____ in. _____ ft.

Sand _____

Gas _____

Oil _____

Total Depth _____

PRODUCTION

1st 24 hrs. Nat. _____

1st 24 hrs. after shot _____

Gas _____ cu. ft.

Dry Hole _____

Abandoned _____

Map No. K Sec. 18 Twp. 25 R. 9

Well No. 1 Hendrickson Farm


Morgan Estate Company
NORTH

Ft. from N. Line

1120 Ft. from S. Line

200 Ft. from E. Line

Ft. from W. Line

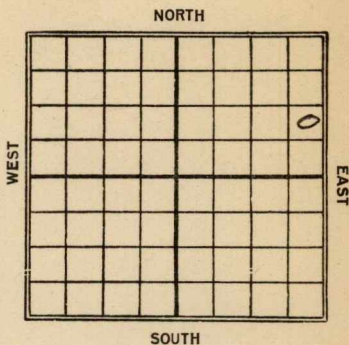

REPORT

Date

2/2	Location
-----	----------

4/24

7/2	1320
-----	------

10/8	S. + q. 2506'
------	---------------

Map No. KANSAS 15 Sec. 18 Twp. 25 R. 9Well No. #1 HendricksonMorgan et al Company

Contractor

FIRST REPORT

SECTION PLAT

			0

Ft. from N. Line

1120 Ft. from S. Line200 Ft. from E. Line

Ft. from W. Line

Location LV

Rig up

Drilling and Remarks:

RECORD

Cased _____ in., _____ ft.

Sand _____

Gas _____

Oil _____

Total Depth _____

PRODUCTION

1st 24 hrs. Nat. _____

1st 24 hrs. after shot _____

Gas _____ Cu. Ft.

Dry Hole _____

Abandoned _____

Date

FEB 27 1924

M. A. BENEAR

Scout

KW KANSAS
 Map No. _____ Sec. 18 Twp. 25 R. 9
 Well No. 1 - Hendrickson
Morgan et al Company
 _____ Contractor

ABANDONED

SECTION PLAT

_____ Ft. from N. Line

1120 Ft. from S. Line

200 Ft. from E. Line

_____ Ft. from W. Line

			0

Location _____

Rig up _____

Drilling and Remarks:

2049
2506'

RECORD

Cased _____ in., _____ ft.

Sand _____

Gas _____

Oil _____

Total Depth _____

PRODUCTION

1st 24 hrs. Nat. _____

1st 24 hrs. after shot _____

Gas _____ Cu. Ft.

Dry Hole _____

Abandoned _____

Date

OCT 8 1924

M. A. BENEAR

192

Scout