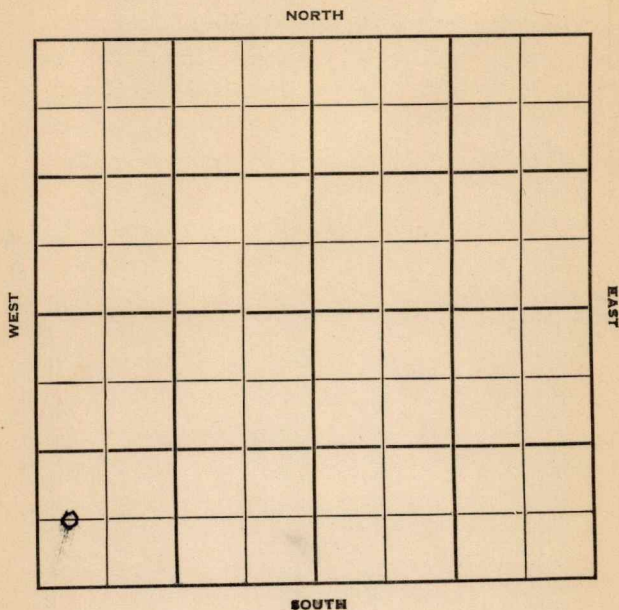


Section 35 Township 25 Range 10EWell No. #3 PolhamusCompany Gould et al

KANSAS

Greenwood

Sec. 35 Twp. 25 R. 10-E

Well No. #3 Polhaus Farm

Gould et al Company

Contractor


Ft. from N. Line

660 Ft. from S. Line

Ft. from E. Line

330 Ft. from W. Line

C W L SW SW

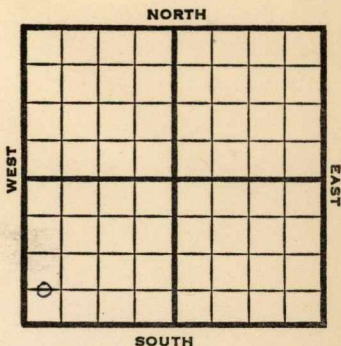

1950

?

REPORT

7/26

Drlg 175

8/23

8 5/8" @ 68

Miss 1993

5" @ 2005

TD 2014

500 A

Comp 20 bopd

Completed

COMPLETED

Kansas

Map No. _____ Sec. 35 Twp. 25 R. 10EWell No. 3 PolhamusGould et al.

Company

Contractor

C W L SW SW

SECTION PLAT



_____ Ft. from N. Line

660 Ft. from S. Line

_____ Ft. from E. Line

330 Ft. from W. LineGreenwood County

Location _____

Rig up _____

Drilling and Remarks:

drlg. 175

RECORD

Cased _____ in., _____ ft.

Sand _____

Gas _____

Oil _____

Total Depth _____

PRODUCTION

1st 24 hrs. Nat. _____

1st 24 hrs. after shot _____


Gas _____ Cu. Ft.

Dry Hole _____

Abandoned _____

Date

JUL 26 1950 19J. E. TYRA Scout

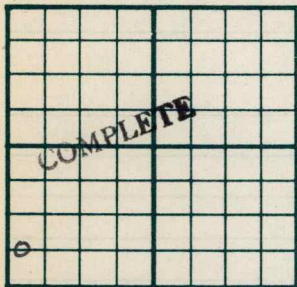County Greenwood State KansasSec. 35 (Blk.
Twp.) 25 (Sur.
Rge.) 10E Map No.Operator Gould etal.Well No. 3 Farm PolhamusElev. Location C W L SW SW660 Ft. From S Line SW330 Ft. From W Line Quarter

1st. Report

Completion AUG 23 1950

Remarks

Spudding Date

Drlg. Data Oil well TD 20148 5/8" @ 68 Miss. 1993 5" @ 2005TD 2014 500 A Comp. 20 bopd

J. E. TYRA