

Map No. K Sec. 17 Twp. 25 R. 9


Well No. 1 Water Farm _____
Hayes + Roberts Company

_____ Ft. from N. Line

300 Ft. from S. Line

300 Ft. from E. Line

_____ Ft. from W. Line

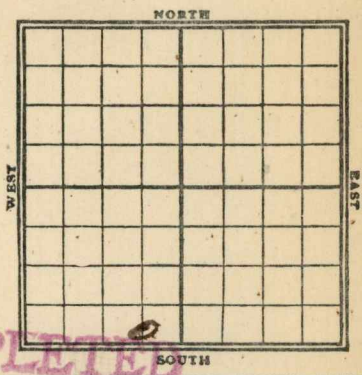

COMPLETED

Date REPORT
FIRST REPORT

6/3	Spud.
17	Log 1675
23	2000
7/2	sd. 2356-2414
	Shot 120 lbs 1000' oil
10	Trying to shut off water.
22	2356-2402 H.F.O.
	S.R. pipe line.
28	2356-2402-S.D. 2414-120/70

Map No. K15 Sec. 17 Twp. 25 R. 9

Well No. 1 Teter

Hayes & Roberts Company

Contractor

SECTION PLAT

FIRST REPORT

----- Ft. from N. Line

300 Ft. from S. Line

300 Ft. from E. Line

----- Ft. from W. Line

RECORD

Location -----

Rig up -----

Drilling and Remarks:

Spud

Cased ----- in., ----- ft.

Sand -----

Gas -----

Oil -----

Total Depth -----

PRODUCTION

1st 24 hrs. Nat. -----

1st 24 hrs. after shot -----

Gas ----- Cu. Ft.

Dry Hole -----

Abandoned -----

Date

6/3 1920


Pyle

Scout

Map No. K15 Sec. 17 Twp. 25 R. 9

Well No. 1 Peter Farm
Hayes & Roberts Company.

NORTH

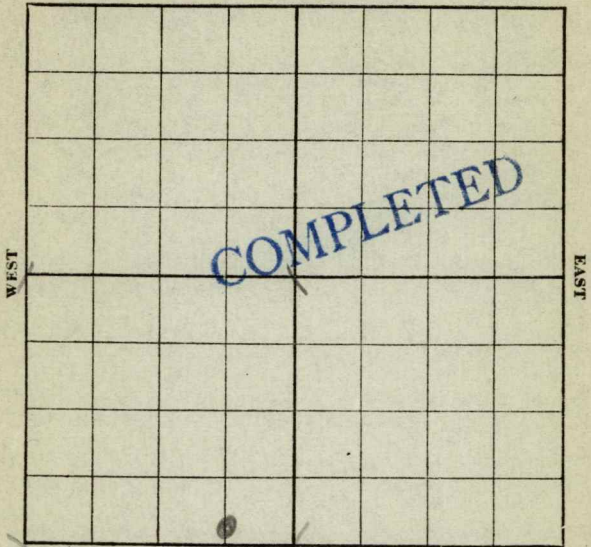

660 E

SOUTH

2005

RECORD

Location -----

Rig up -----

Drilling and Remarks:

Shot 120 qts

Cased ----- in., ----- ft.

Sand 2356-2402

Gas -----

Oil -----

Total Depth 2414

PRODUCTION

1st 24 hrs. Nat. -----

1st 24 hrs. after shot 70 bbls

Gas ----- Cu. Ft.

Dry Hole -----

Abandoned -----

Date

7/28 1920

Cyle

Scout.