


Map No. _____ Sec. 17 Twp. 25 R. 9
Well No. 2 Jeter Farm
Hayes & Roberts Company

N

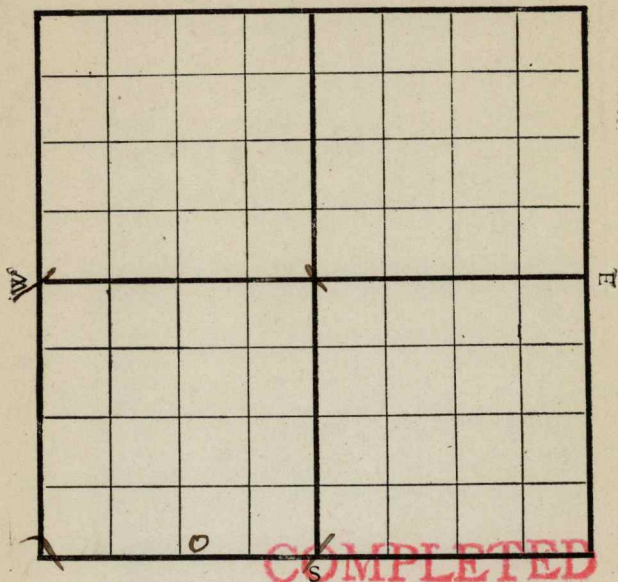

Location -----

Drilling Remarks:

Rig Up -----

Drilling Remarks:

RECORD

Cased ----- in.-----ft.

Sand -----

Gas _____

Oil -----

Total Depth-----

PRODUCTION

1st 24 hrs. Nat.-----

1st 24 hrs. after shot-----

Gas ----- cu. ft.

Dry Hole -----


Abandoned -----

Map No. _____ Sec. 17 Twp. 25 R. 9Well No. 2 Teter Farm _____
Hayes & Roberts Company

_____ Ft. from N. Line

200 Ft. from S. Line1120 Ft. from E. Line

_____ Ft. from W. Line

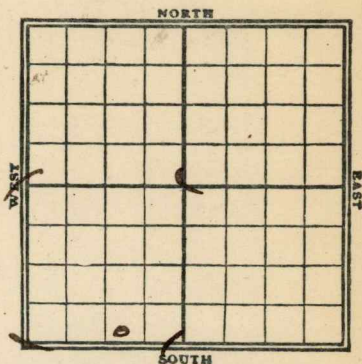

REPORT

FIRST REPORT

COMPLETED

1900	
7/10	Timbers
22	Rig
28	✓
7/6	dlg @ 400'
8/13	dlg @ 700'
8/21	S. dl. @ 1400'
8/27	dlg @ 2000'
9/3	dlg @ 2200'
9/11	✓ ✓ 2360'
9/17	2392-2412-60 bbls.

Map No. K 15 Sec. 17 Twp. 25 R. 9Well No. 2 PeterHayes & Roberts Company

Contractor

SECTION PLAT

Ft. from N. Line

200 Ft. from S. Line1120 Ft. from E. Line

Ft. from W. Line



Location

Rig up

Drilling and Remarks:

Timbers

RECORD

Cased _____ in., _____ ft.

Sand _____

Gas _____

Oil _____

Total Depth _____

PRODUCTION

1st 24 hrs. Nat. _____

1st 24 hrs. after shot _____

Gas _____ Cu. Ft.

Dry Hole _____

Abandoned _____

Date

7/10 1920**Pyle**

Scout

Map No. K15 Sec. 17 Twp. 25 R. 9Well No. 2 PeterHayes & Roberts Company

Contractor

SECTION PLAT

-----Ft. from N. Line

200 Ft. from S. Line1120 Ft. from E. Line

-----Ft. from W. Line

COMPLETED

Location -----

Rig up -----

Drilling and Remarks:

RECORD

Cased ----- in., ----- ft.

Sand 2392 - 2412

Gas -----

Oil -----

Total Depth -----

PRODUCTION

1st 24 hrs. Nat. 60 bbls

1st 24 hrs. after shot -----

Gas ----- Cu. Ft.

Dry Hole -----

Abandoned -----

Date

9/17 19100

Pyle

Scout