
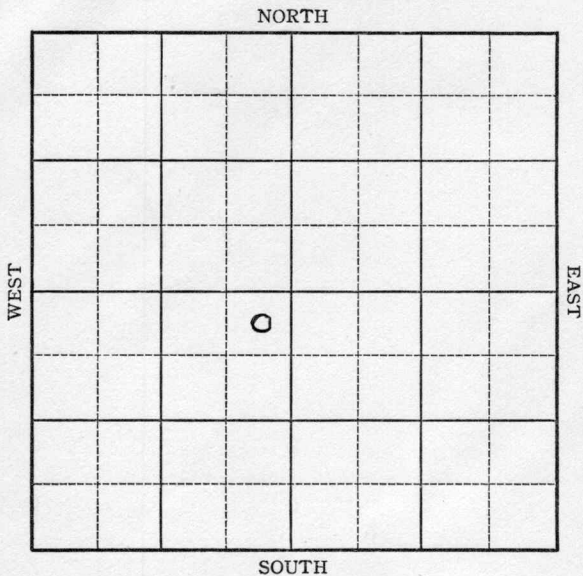


Section 9 Township 24 Range 13-E  
Well No. 1 Slough  
Company Landon & Mendenhall

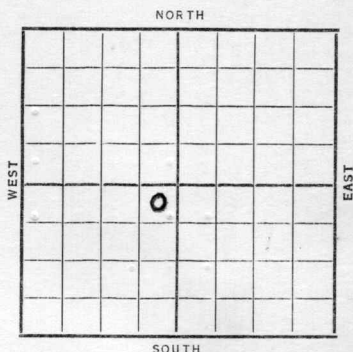

Sec. 9 Twp. 24 R. 13-EWell No. #1 Slough Farm  
Landon & Mendenhall Company330 Ft. from N. Line       Ft. from S. Line330 Ft. from E. Line       Ft. from W. Line

Date

REPORT

1938

1/12

R U M

1/20

S.D.

1/28

" "

2/4

" "

2/11

10" @ 700'. Drlg. 1050'.

2/18

Burgess sand 1580-85'.

Miss. 1587'. Drlg. 1675'.

No shows.

2/26

" " " " "

3/4

Shut down.

3/11

Base Miss. 1874'. 5" @ 1882'.

Drlg. 1890'.

3/18

SD 1890'?

OVER

1938

3/23 5" @ 1882'.  
Arb. 1973'.  
T.D. 1980'.  
H.F.W.

COMPLETED

Greenwood KANSAS

Map No. 17 Sec. 9 Twp. 24 R. 13EWell No. 1 SloughLandon & Mendenhall Company

Contractor

## FIRST REPORT

NE SW

330 Ft. from N. Line       Ft. from S. Line330 Ft. from E. Line       Ft. from W. Line

## SECTION PLAT

|  |   |  |  |
|--|---|--|--|
|  |   |  |  |
|  |   |  |  |
|  | 0 |  |  |
|  |   |  |  |

Location                     Rig up                     

Drilling and Remarks:

RUM

## RECORD

Cased            in.,            ft.Sand                     Gas                     Oil                     Total Depth                     

## PRODUCTION

1st 24 hrs. Nat.                     1st 24 hrs. after shot                     Gas                      Cu. Ft.Dry Hole                     Abandoned                     

Date

JAN 12 1938

19

H. D. Hatfield

Scout

Greenwood

KANSAS

Map No. 17 Sec. 9 Twp. 24 R. 13EWell No. 1 SloughLandon & Mendenhall Company

Contractor

ABANDONED

NE SW

330 Ft. from N. Line       Ft. from S. Line330 Ft. from E. Line       Ft. from W. Line

## SECTION PLAT

|  |   |  |  |
|--|---|--|--|
|  |   |  |  |
|  |   |  |  |
|  | 0 |  |  |
|  |   |  |  |

Location                                 Rig up                                 

Drilling and Remarks:

HFW

D.V.A.

## RECORD

Cased 5 in., 1882 ft.Sand Arb 1973Gas                                 Oil                                 Total Depth 1980

## PRODUCTION

1st 24 hrs. Nat.                                 1st 24 hrs. after shot                                 Gas                                  Cu. Ft.Dry Hole                                 Abandoned                                 

Date

MAR 23 1930

19

H. D. Hatfield Scout