


Section 18 Township 25 Range 9 E

Well No. # 1 Teeter Spencer

Company Ward McGinnis

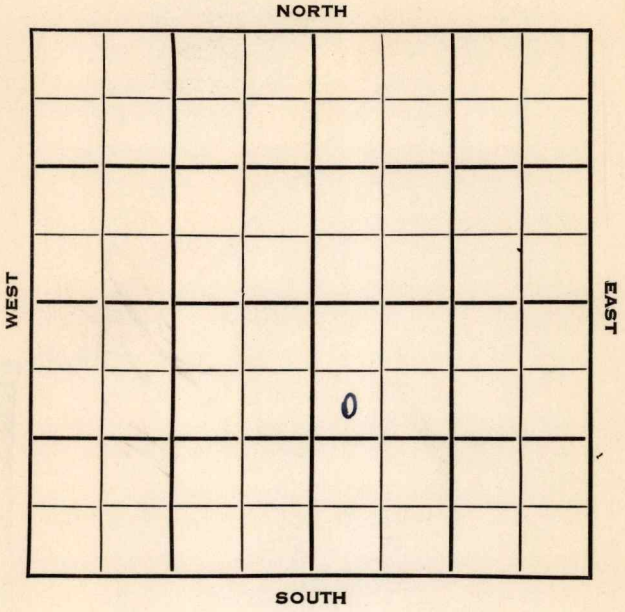

Greenwood

Sec. 18 Twp. 25 R. 9E

Well No. #1 Teeter Spencer Farm

Ward McGinnis Company

McGinnis Contractor

Thrall-Agard Pool


990 Ft. from N. Line

Ft. from S. Line

Ft. from E. Line

330 Ft. from W. Line

SW NW SE

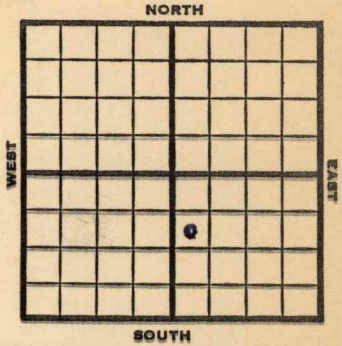

1953

Elev. --

REPORT

7/1

Spud 6-26-53

8" @ 70'

Drlg. 2100'

7/22

Spud 6-26-53

Oil Well

TD 2470'

8" @ 70'

Bart 2430

TD 2453'

5" @ 2453'

DD 2460 DD 2470 Hydro.

Comp. 10 bopd.

COMPLETED



