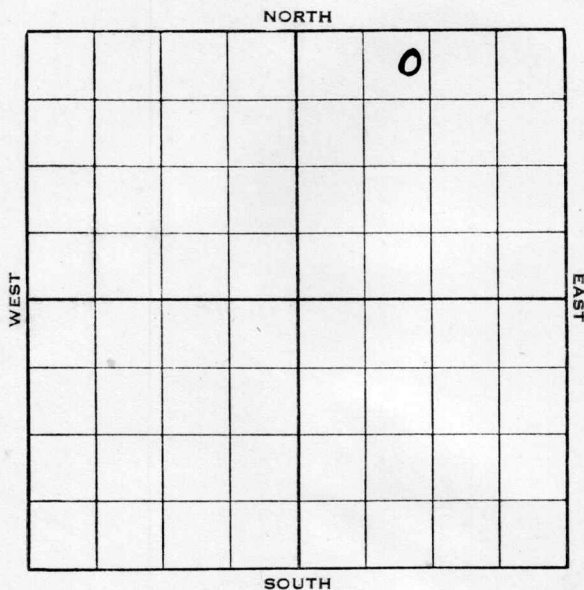
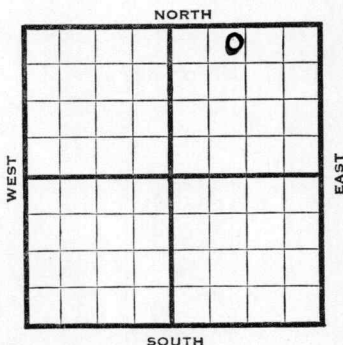


Greenwood

KANSAS

Section 17 Township 24 Range 12-EWell No. 4 ThrallCompany Shull Drlg.

KANSAS Greenwood

Sec. 17 Twp. 24 R. 12-EWell No. #4 Thrall Farm
Shull Drilling Company300 Ft. from N. Line Ft. from S. Line Ft. from E. Line1040 Ft. from W. Line

1938

REPORT

3/23

12" @ 36'.

Drlg. 660'.

4/1

10" @ 705'. 8" @ 1282'.

Drlg. 1400'.

4/6

7" @ 1786'.

Miss. 1786'.

T.D. 1850'.

COMPLETED

Greenwood KANSAS

Map No. 16^M Sec. 17 Twp. 24 R. 12EWell No. 4 ThrallShull Drlg.

Company

Contractor

FIRST REPORT

NE NW NE

300 Ft. from N. Line

Ft. from S. Line

Ft. from E. Line

1040 Ft. from W. Line

SECTION PLAT

		0	

Location

Rig up

Drilling and Remarks:

12" - 36Drlg. 660

RECORD

Cased _____ in., _____ ft.

Sand _____

Gas _____

Oil _____

Total Depth _____

PRODUCTION

1st 24 hrs. Nat. _____

1st 24 hrs. after shot _____

Gas _____ Cu. Ft.

Dry Hole _____

Abandoned _____

Date

MAR 23 1938H. D. Hatfield Scout

Greenwood KANSAS

Map No. 16^M Sec. 17 Twp. 24 R. 12EWell No. 4 Thrall

Shull Drlg.

Company

Contractor

ABANDONED

NE NW NE

300 Ft. from N. Line

Ft. from S. Line

Ft. from E. Line

1040 Ft. from W. Line

SECTION PLAT

		0	

Location

Rig up

Drilling and Remarks:

RECORD

Cased 7 in., 1786 ft.Sand MISS 1786

Gas

Oil

Total Depth 1850

PRODUCTION

1st 24 hrs. Nat.

1st 24 hrs. after shot

Gas Cu. Ft.

Dry Hole

Abandoned

Date

APR 6 - 1938

19

H. D. Hatfield

Scout