


Map No. K Sec. 19 Twp. 25 R. 9

Well No. 5 Sudd Farm  
Mid-Kansas Company

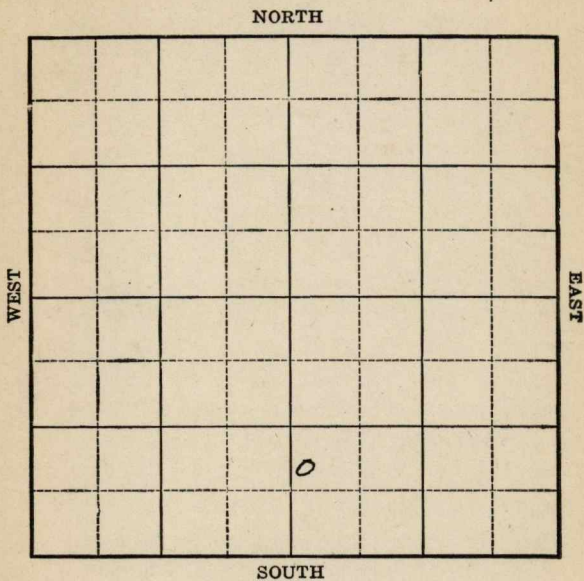

Location \_\_\_\_\_

Rig Up \_\_\_\_\_

Drilling Remarks:

Drilling Remarks:

\_\_\_\_\_

\_\_\_\_\_

**RECORD**

**PRODUCTION**

Cased \_\_\_\_\_ in. \_\_\_\_\_ ft.

1st 24 hrs. Nat. \_\_\_\_\_

Sand \_\_\_\_\_

1st 24 hrs. after shot \_\_\_\_\_

Gas \_\_\_\_\_

Gas \_\_\_\_\_ cu. ft.

Oil \_\_\_\_\_

Dry Hole \_\_\_\_\_

Total Depth \_\_\_\_\_

Abandoned \_\_\_\_\_



**KANSAS**

Map No. \_\_\_\_\_ Sec. 19 Twp. 25 R. 9

Well No. 5 Ladd

Mid-Kansas Company

Contractor \_\_\_\_\_

**FIRST REPORT**

**SECTION PLAT**

\_\_\_\_\_ Ft. from N. Line

735 Ft. from S. Line

\_\_\_\_\_ Ft. from E. Line

200 Ft. from W. Line


Location ✓✓

Rig up \_\_\_\_\_

Drilling and Remarks:

**RECORD**

Cased \_\_\_\_\_ in., \_\_\_\_\_ ft.

Sand \_\_\_\_\_

Gas \_\_\_\_\_

Oil \_\_\_\_\_

Total Depth \_\_\_\_\_

**PRODUCTION**

1st 24 hrs. Nat. \_\_\_\_\_

1st 24 hrs. after shot \_\_\_\_\_

Gas \_\_\_\_\_ Cu. Ft.

Dry Hole \_\_\_\_\_

Abandoned \_\_\_\_\_

Date

FEB 27 1924

M. A. BENEAR

192

Scout

15 **KANSAS**  
Map No. \_\_\_\_\_ Sec. 19 Twp. 25 R. 9

Well No. 5 Ladd

Mid-Kansas Company

Contractor \_\_\_\_\_

# COMPLETED

## SECTION PLAT

\_\_\_\_\_ Ft. from N. Line

735 \_\_\_\_\_ Ft. from S. Line

\_\_\_\_\_ Ft. from E. Line

200 \_\_\_\_\_ Ft. from W. Line

		0	

Location \_\_\_\_\_

Rig up \_\_\_\_\_

Drilling and Remarks:

sand, 2356-2447

120/140

### RECORD

Cased \_\_\_\_\_ in., \_\_\_\_\_ ft.

Sand \_\_\_\_\_

Gas \_\_\_\_\_

Oil \_\_\_\_\_

Total Depth \_\_\_\_\_

### PRODUCTION

1st 24 hrs. Nat. \_\_\_\_\_

1st 24 hrs. after shot \_\_\_\_\_

Gas \_\_\_\_\_ Cu. Ft.

Dry Hole \_\_\_\_\_

Abandoned \_\_\_\_\_

Date

MAY 22 1924

M. A. BENEAR

\_\_\_\_\_ 192\_\_\_\_\_

\_\_\_\_\_ Scout