


SECTION 18 TOWNSHIP 25 RANGE 9 E

WELL NO. #1 Spencer Teter

COMPANY Johns & McGathan

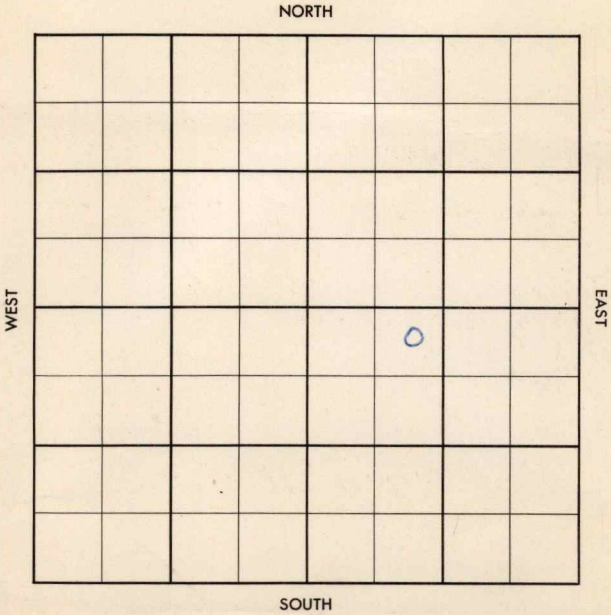

Greenwood

KANSAS

SEC. 18	TWP. 25	R. 9E
------------	------------	----------

WELL NO.

#1 Spencer Teter

FARM

COMPANY

Johns & McGathan

CONTRACTOR

Ola Berentz


330 Ft. from N. Line

Ft. from S. Line

1460 Ft. from E. Line

Ft. from W. Line

NE NW SE

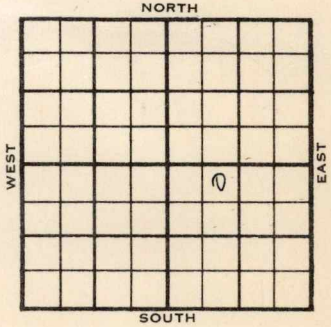

1955

ELEVATION

REPORT

12-14 Comm. ~~###~~ 12-10-55
8" @ 110
Drlg. 200

12-21 D & A
L. 1713
Bart 2355-75
TD 2425'

ABANDONED

County **Greenwood** Elev. _____
 Sec. **18** Twp. **25** Rge. **9E**
 Company **Johns & McGathan**
 Farm Name **Spencer Teter** No. **1**

TOPS	DEPTH	LOG	DATUM
Anh.			
Tp.			
H.			
Tr.			
Dg.			
BL.			
L.			
K.C.			
B.K.C.			
Ce.			
C.			
M.			
M.			
K.			
Mz.			
Me.			
V.			
S.			
S.			
A.			
R.			
PE.			
G.			
T.D.			

Loc. in Sec. _____

NE NW SE**330' NL****1460' EL**

Geol. _____

Contr. _____

Ola Berentz

Pool _____

Date Comm. **12-10-55****8" @ 110 rlg. 200**

County Greenwood Elev. _____ Co. _____
 Sec. 18 Twp. 25 Rge. 9E
 Company Johns & McGathan
 Farm Name Spencer Teter No. 1

TOPS	DEPTH	LOG	DATUM
Anh.			
Tp.			
H.			
Tr.			
Dg.			
BL.			
L.	<u>1713</u>		
K.C.			
B.K.C. <u>Bart</u>	<u>2355-75</u>		
Ce.			
C.			
M.			
M.			
K.			
Mz.			
Mq.			
V.			
S.			
S.			
A.			
R.			
PE.			
G.			
T.D.	<u>2425</u>		

Loc. in Sec. _____

NE NW SE

330' NL

1460' EL

Geol. _____

Contr. _____

Ola Berentz

Pool _____

ABANDONED

Date Comm. 12-10-55

DEC 21 1955

8" @ 110

D & A