

Map No. Kanesh Sec. 19 Twp. 25 R. 9

Well No. 1 Ladd Farm

Mid-Kansas Company

NORTH

WEST

EAST

0

SOUTH

Location

Drilling Remarks

Rig Up

Drilling Remarks

RECORD

Cased _____ in. _____ ft.

Sand _____

Gas

Oil

Total Depth.....

PRODUCTION

1st 24 hrs. Nat.-----

1st. 24 hrs. after shot_____

Gas.....cu. ft.

Dry Hole


Abandoned

Map No. Kansas Sec. 19 Twp. 25 R. 9Well No. 1 Ladd Farm
Mud-Kansas Company

Ft. from N. Line

520 Ft. from S. Line1120 Ft. from E. Line

Ft. from W. Line

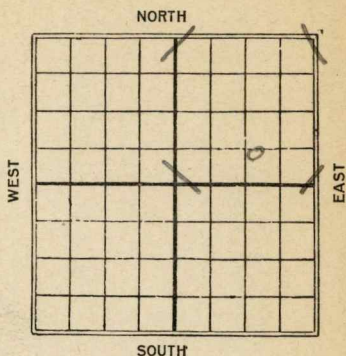

C

Date	REPORT
1925	
5/21	Location
5/29	help rig
6/5	Rig
6/12	Rig
6/19	
6/26	
7/3	
7/10	Rig up
7/17	600
7/24	1200'
7/31	1560'
8/7	2200'
8/14	Broken. 2324-90
	Oil 2390-2408'
	40/150 bbls

Map No. 15400 Sec. 19 Twp. 25 R. 9Well No. 1 2400Mid-Isan St Company

Contractor


FIRST REPORTS

Ft. from N. Line

520 Ft. from S. Line1120 Ft. from E. Line

Ft. from W. Line

SECTION PLAT

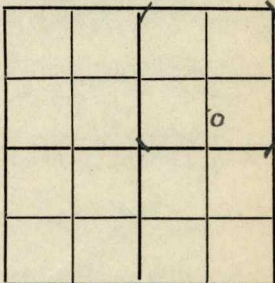Location ✓

Rig up

Drilling and Remarks:

RECORD

Cased _____ in., _____ ft.

Sand _____

Gas _____

Oil _____

Total Depth _____

PRODUCTION

1st 24 hrs. Nat. _____

1st 24 hrs. after shot _____

Gas _____ Cu. Ft.

Dry Hole _____

Abandoned _____

Date

MAY 21 1925

192

CHAS. L. SHERWOOD
Scout

Sherwood Co

Map No. **KANSAS** Sec. *19* Twp. *25* R. *9*

Well No. *1 Lado*

Mid-Kanals Company

Contractor

COMPLETED

SECTION PLAT

Ft. from N. Line


520

Ft. from S. Line

1120

Ft. from E. Line

Ft. from W. Line

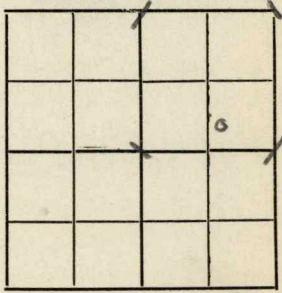

Location

Rig up

Drilling and Remarks:

Broken at 2324-90'

oil sand 2390-2408'

44 150 bhs.

RECORD

Cased _____ in., _____ ft.

Sand _____

Gas _____

Oil _____

Total Depth *2408'*

PRODUCTION

1st 24 hrs. Nat. _____

1st 24 hrs. after shot _____

Gas _____ Cu. Ft.

Dry Hole _____

Abandoned _____

Date

AUG 14 1925

CHAS. L. SHERWOOD

_____ 192 _____ Scout