

Map No. _____ Sec. 19 Twp. 25 R. 9

Well No. 3 Ladd Farm
Mid-Kansas Company

Mid-Kansas Company

NORTH

WEST

EAST

SOUTH

Location _____

Drilling Remarks:

Rig Up _____

Drilling Remarks:

RECORD

Cased _____ in. _____ ft.

Sand _____

Gas _____

Oil_____

Total Depth_____

PRODUCTION

1st 24 hrs. Nat. _____

1st 24 hrs. after shot

Gas _____ cu. ft.

Dry Hole _____

Abandoned_____

Map No. K Sec. 19 Twp. 25 R. 9

Well No. 3 Ladd Farm


Mid-Kansas Company

_____ Ft. from N. Line

250 Ft. from S. Line

_____ Ft. from E. Line

250 Ft. from W. Line

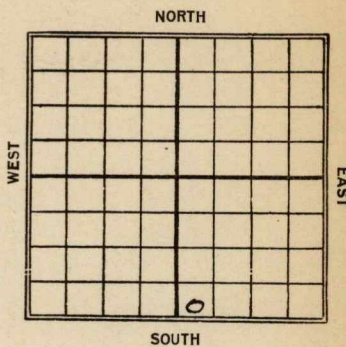

REPORT

Date 4/15
4/15
8/127

Rey up
and 23 80-2466
320. 2470'
120/150 Bbls

Map No. **KANSAS** Sec. **19** Twp. **25** R. **9**
 Well No. **3-Ladd**
Mid-Kansas Company
 Contractor

FIRST REPORT

SECTION PLAT

----- Ft. from N. Line
250 ----- Ft. from S. Line
 ----- Ft. from E. Line
250 ----- Ft. from W. Line

Location -----
 Rig up **✓✓** -----
 Drilling and Remarks:

RECORD

Cased ----- in., ----- ft.
 Sand -----
 Gas -----
 Oil -----
 Total Depth -----

PRODUCTION

1st 24 hrs. Nat. -----
 1st 24 hrs. after shot -----
 Gas ----- Cu. Ft.
 Dry Hole -----
 Abandoned -----

Date

JAN 15 1924

M. A. BENEAR

191

Scout

Map No. **KANSAS** 15 Sec. 19 Twp. 25 R. 9

Well No. 3 Ladd

Mid Kansas Company

Contractor

COMPLETED SECTION PLAT

Ft. from N. Line

250 Ft. from S. Line

Ft. from E. Line

250 Ft. from W. Line

Location

Rig up

Drilling and Remarks:

Sand 2380-2466

T.O. 2470

120/150 Hb

RECORD

Cased _____ in., _____ ft.

Sand _____

Gas _____

Oil _____

Total Depth _____

PRODUCTION

1st 24 hrs. Nat. _____

1st 24 hrs. after shot _____

Gas _____ Cu. Ft.

Dry Hole _____

Abandoned _____

Date

FEB 27 1924

M. A. BENEAR

192

Scout