

Form 51—5M—11-31—Palace
Map No. KANSAS Sec. 17 Twp. 24 R. 12^E
Well No. 1 Crall Farm
Hard M^c Ginnis Company

WEST

EAST

SOUTH


Drilling Remarks

Total Depth.....

Abandoned

Map No. KANSAS Sec. 17 Twp. 24 R. 12^E
Well No. 1-Thrall Farm
Ward McEinnis Company

NORTH

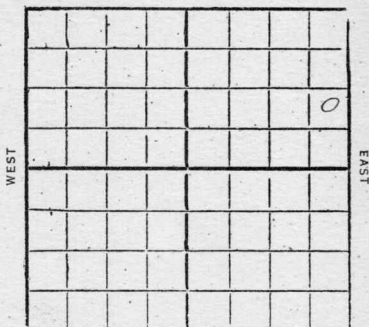

Ft. from N. Line

1100 Ft. from S. Line

220 Ft. from E. Line

Ft. from W. Line

1932

Date

REPORT

10/5 Machine
10/12 Drilg 300'
10/19 " 735
10/26 " 1400'
11/2 Top line 1800'
DUIR 6"-to 1817
Good show oil
11/9 Csm 6"-1817'
11/16 TD 1838
shot 20 qt
swab 15 bbl 24 hr
11/23 Cased 6"-1817
Top line 1800'
Cased 1817-38
TD 1838
shot 20 qt
Pump 15 bbl
Comp.

Greenwood

E

Map No. *KANSAS* Sec. *17* Twp. *24* R. *12*

Well No. *1* *Thall*

Ward Mc Ginnis Company

Contractor

FIRST REPORTS

Ft. from N. Line

1100 Ft. from S. Line

220 Ft. from E. Line

Ft. from W. Line

SECTION PLAT

Location

Rig up *Machine*

Drilling and Remarks:

RECORD

Cased in., ft.

Sand

Gas

Oil

Total Depth

PRODUCTION

1st 24 hrs. Nat.

1st 24 hrs. after shot

Gas Cu. Ft.

Dry Hole

Abandoned

Date

OCT 5 1932

192

CHAS. L. SHERWOOD

Scout

Greenwood

16 KANSAS

Map No. Sec. 17 Twp. 24 R. 12^E

Well No. 1 Thrall

Naro Mc Ginnis

Company

Contractor

COMPLETED

SECTION PLAT

			o

Ft. from N. Line

1100 Ft. from S. Line

220 Ft. from E. Line

Ft. from W. Line

Location

Rig up

Drilling and Remarks:

Top Line 1800
Shot 20 gts
Pump 15 lbs.

RECORD

Cased 6 in., 1817 ft.

Sand 1817-1838

Gas

Oil

Total Depth 1838

PRODUCTION

1st 24 hrs. Nat.

1st 24 hrs. after shot

Gas Cu. Ft.

Dry Hole

Abandoned

Date

NOV 23 1932 CHAS. L. SHERWOOD

192

Scout