


KANSAS

Stanton

Section 11 Township 28 Range 39W

Well No. 1 Pifeger

Company Stanolind

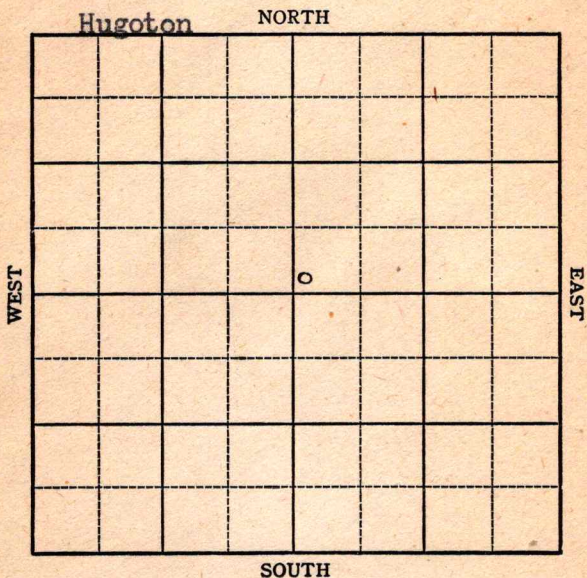

KANSAS
Stanton ✓

Sec. 11 Twp. 28 R. 39W

Well No. #1 Pifeger Farm

Stanolind Company

Hugoton


 Ft. from N. Line

50 Ft. from S. Line

 Ft. from E. Line

50 Ft. from W. Line

SW NE

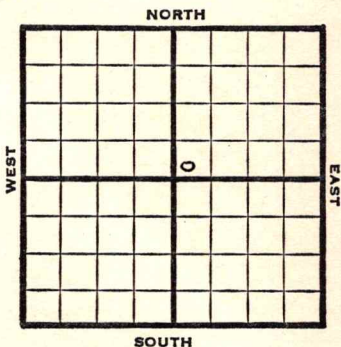

1947 **Elev. 3136** REPORT

4/2 8" @ 670'
Drlg. 1250'.

4/9 Drlg. 1825'.

4/15 Drlg. 2455'

4/23 TD 2486'
5" @ 2456'
RUST

4/30 5" @ 2456
Perf
14,000 Acid
3,531,000 Gas
405# R Pr
TD 2492'

COMPLETED

Map No. _____ Sec. 11 Twp. 28 R. 39W

Well No. 1 Pifeger

Stanolind Company

FIRST REPORT Contractor

SW NE


SECTION PLAT

_____ Ft. from N. Line

50 Ft. from S. Line

_____ Ft. from E. Line

60 Ft. from W. Line

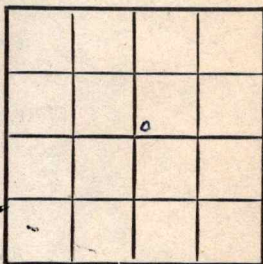

Stanton County

Location _____

Rig up _____

Drilling and Remarks:

8" @ 670

drlg. 1250

RECORD

Cased _____ in., _____ ft.

Sand _____

Gas _____

Oil _____

Total Depth _____

PRODUCTION

1st 24 hrs. Nat. _____

1st 24 hrs. after shot _____

Gas _____ Cu. Ft.

Dry Hole _____

Abandoned _____

Date

APR 2 1947 19

S. J. LEWIS Scout

Kansas

KANSAS

Map No. _____ Sec. 11 Twp. 28 R. 39WWell No. 1 Pifeger

Stanolind

Company

COMPLETE

Contractor

SW NE

E 13136

SECTION PLAT

_____ Ft. from N. Line

50 _____ Ft. from S. Line

_____ Ft. from E. Line

50 _____ Ft. from W. Line

Stanton County

Location _____

Rig up _____

Drilling and Remarks:

5102406
Perf.
14000 acid

3,531,000 Gas

405 R Pa*

RECORD

Cased _____ in., _____ ft.

Sand _____

Gas _____

Oil _____

Total Depth 2492.

PRODUCTION

1st 24 hrs. Nat. _____

1st 24 hrs. after shot _____

Gas _____ Cu. Ft.

Dry Hole _____

Abandoned _____

Date

APR 30 1947 19

S. J. LEWIS

Scout