


Section 18 Township 24 Range 12E

Well No. #1 Fry

Company Miller & Snyder

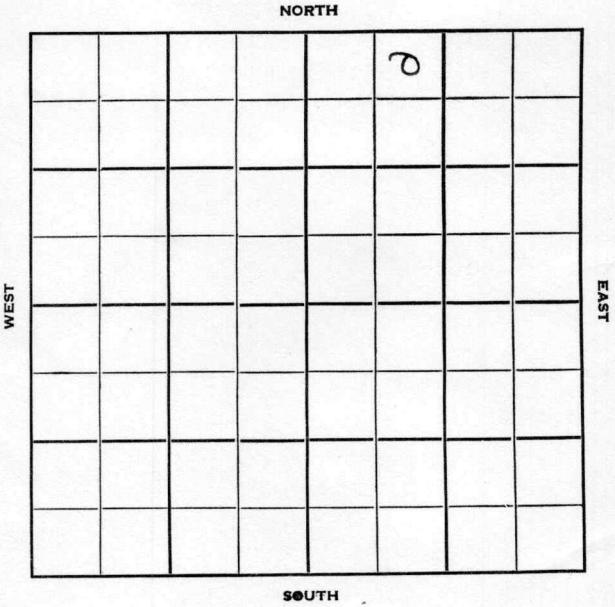

Greenwood KANSAS

Sec. 18 Twp. 24 R. 12 E

Well No. # 1 Fry Farm

Miller & Snyder Company

Contractor

Hamilton Pool


330 Ft. from N. Line

_____ Ft. from S. Line

_____ Ft. from E. Line

990 Ft. from W. Line

NE NW NE

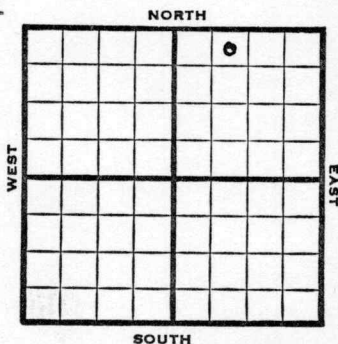

1952

Elev. -

REPORT

1/2

Miss 1818-32'
5" @ 1830'

1/16

Oil well TD 1839' Miss 1818-32'
5" @ 1830 TD 1839' 1000 A
Comp. 5 BOPD

COMPLETED

County Greenwood State KansasSec. 18 (Blk. Twp.) 24 (Sur. Rge.) 12E Map No.Operator Miller & SnyderWell No. 1 Farm FryElev. Location NE NW NE

0

FIRST REPORT

330 Ft. From N Line NE990 Ft. From W Line Quarter1st. Report JAN 2 1952


Completion

Remarks

Spudding Date

Drlg. Data Hamilton PoolMiss. 1818-32 5" @ 1830

County Greenwood State Kansas
 Sec. 18 (^{Blk.}_{Twp.}) 24 (^{Sur.}_{Rge.}) 12E Map No. _____
 Operator Miller & Snyder
 Well No. 1 Farm Fry
 Elev. _____ Location NE NW NE

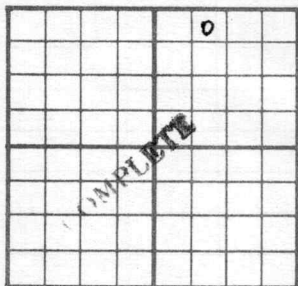

330 Ft. From N Line NE
990 Ft. From W Line Quarter
 1st. Report _____
 Completion JAN 16 1952
 Remarks Hamilton Pool

Spudding Date _____

Drlg. Data Oil well TD 1839
Miss. 1818-32 5" @ 1830 TD 1839
1000 A Comp. 5 bopd

J. E. TYRA