

KANSAS

Barton

Section 31 Township 20 Range 15WWell No. 4 GilbertCompany Anderson-Prichard et al

Ash Creek		NORTH					
WEST							
		0					
		SOUTH					
EAST							

KANSAS

Barton

Sec. 31 Twp. 20 R. 15W

Well No. #4 Gilbert Farm

Anderson Prichard et al

Ash Creek Pool Company


Ft. from N. Line

990' Ft. from S. Line

Ft. from E. Line

990' Ft. from W. Line

NE SW NW

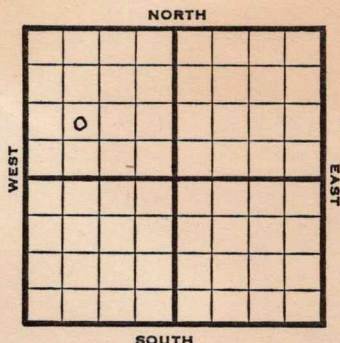

1948 Elev. 1998' REPORT

3/10 Location

3/17 "

3/24 "

3/31 8" @ 994'
Drig. 1000'

4/7 Arbuckle 3759'
TD 3813' SO
Run 5"

4/14 TD 3816'
5" @ 3813'

4/21 Flow 35 bbls oil 5 hrs.

4/28 "

5/5 Arbuckle 3759'
5" @ 3813'
250 Acid
Flow 210 Oil Pot.
Gr. 39°
TD 3816'

COMPLETED

Map No. _____ Sec. 31 Twp. 20 R. 15W

Well No. 4 Gilbert

Anderson Prichard et al. Company

FIRST REPORT Contractor

NE SW NW

SECTION PLAT

o			

_____ Ft. from N. Line

990 Ft. from S. Line

_____ Ft. from E. Line

990 Ft. from W. Line

Barton County

Location x

Rig up _____

Drilling and Remarks:

RECORD

Cased _____ in., _____ ft.

Sand _____

Gas _____

Oil _____

Total Depth _____

PRODUCTION

1st 24 hrs. Nat. _____

1st 24 hrs. after shot _____

Gas _____ Cu. Ft.

Dry Hole _____

Abandoned _____

Date

MAR 10 1948 19 S. J. LEWIS Scout

Map No. 82 Sec. 31 Twp. 20 R. 15W

Well No. 4 Gilbert

Anderson-Prichard et al. Company

COMPLETE

Contractor

NE SW NW

E 4/1988

SECTION PLAT

 Ft. from N. Line

990 Ft. from S. Line

 Ft. from E. Line

990 Ft. from W. Line

0			
2			

Barton County

Location

Rig up

Drilling and Remarks:

Cur X 3758
5" casing
2500 acid
Flow 210 oil
892 ft

RECORD

Cased in., ft.

Sand

Gas

Oil

Total Depth 8876

PRODUCTION

1st 24 hrs. Nat.

1st 24 hrs. after shot

Gas Cu. Ft.

Dry Hole

Abandoned

Date

MAY 5 1948

19

S. J. LEWIS

Scout