


Map No. **KANSAS** Sec. **18** Twp. **24** R. **12 E**
 Well No. **Ward Mc Scott** Farm
Ward Mc Ginnis Company

NORTH

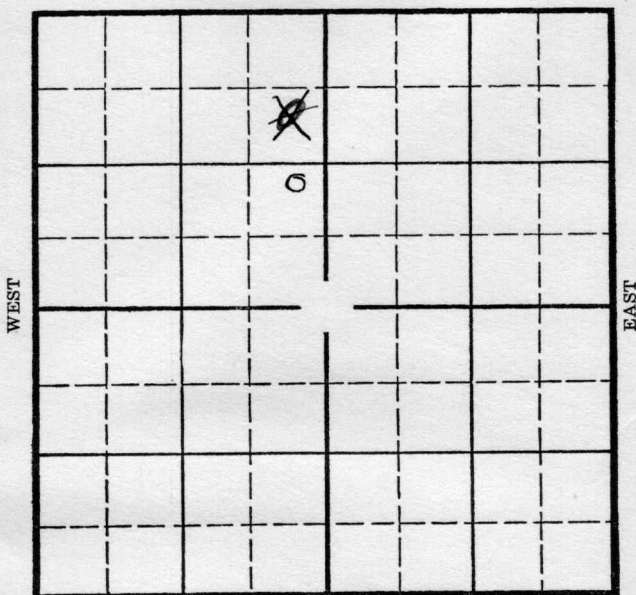

SOUTH

Location _____
 Drilling Remarks _____

Rig Up _____
 Drilling Remarks _____

RECORD

Cased _____ in. _____ ft.
 Sand _____
 Gas _____
 Oil _____
 Total Depth _____

PRODUCTION


1st 24 hrs. Nat. _____
 1st 24 hrs. after shot _____
 Gas _____ cu. ft. _____
 Dry Hole _____
 Abandoned _____

Greenwood

Map No. Sec. 18 Twp. 24 R. 12E

Well No. 1 - A. Scott Farm
Ward Mc Hinnis Company

~~990~~ Ft. from N. Line
990 Ft. from S. Line
330 Ft. from E. Line
Ft. from W. Line

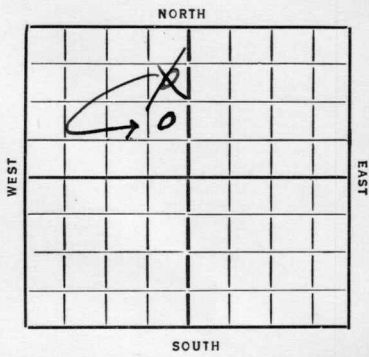

REPORT

~~1936~~
1/8 Machine
1/17 Spud
1/24 Pkg 350
1/31 SD 550
2/7 — 2/14 — 2/21 —
2/28 Pkg 700
3/6 " 1410
3/11 TL 1803
TD 1850
D. A.

ABANDONED

Map No. 16 Sec. 18 Twp. 24 R. 12 E

Well No. 1-9 Scott

Ward Mc Ginnis Company

Contractor

SECTION PLAT

990 Ft. from N. Line

..... Ft. from S. Line

320 Ft. from E. Line

..... Ft. from W. Line

	0		

FIRST REPORT

Location.....

Rig up.....

Drilling and Remarks:

Machine

RECORD

Cased.....in.,ft.

Sand.....

Gas.....

Oil.....

Total Depth.....

PRODUCTION

1st 24 hrs. Nat.....

1st 24 hrs. after shot.....

Gas.....Cu. Ft.

Dry Hole.....

Abandoned.....

Date

JAN 8 1936 192.....Scout

ORVAL MANNSCHRECK

KANSAS

Map No. 16 Sec. 18 Twp. 24 R. 12E

Well No. 1-A Scott

Ward McGinnis Company

Contractor

NE SE NW

CORRECTION

.....Ft. from N. Line

990 Ft. from S. Line

330 Ft. from E. Line

.....Ft. from W. Line

CORRECTION

SECTION PLAT

	0		

Location.....

Rig up.....

Drilling and Remarks:

*Incorrectly
reported as being
located in the
SE NE NW*

RECORD

Cased.....in.,ft.

Sand.....

Gas.....

Oil.....

Total Depth.....

PRODUCTION

1st 24 hrs. Nat.....

1st 24 hrs. after shot.....

Gas.....Cu. Ft.

Dry Hole.....

Abandoned.....

Date

1-15-36 192... O. Mannschreck Scout

Map No. 16 Sec. 18 Twp. 24 R. 12EWell No. 1-G. ScottW. McKinis Company

Contractor

ABANDONED

SECTION PLAT

	0		

Ft. from N. Line

990 Ft. from S. Line330 Ft. from E. Line

Ft. from W. Line

Location

Rig up

Drilling and Remarks:

RECORD

Cased _____ in., _____ ft.

Sand TL 1803

Gas _____

Oil _____

Total Depth 1850

PRODUCTION

1st 24 hrs. Nat. _____

1st 24 hrs. after shot _____

Gas _____ Cu. Ft.

Dry Hole _____

Abandoned _____

Date

ORVAL MANNSCHRECK

3-11-36 192 _____ Scout