


Section 18 Township 24 Range 12EWell No. #1 FryCompany Chas. Miller

NORTH

WEST

EAST

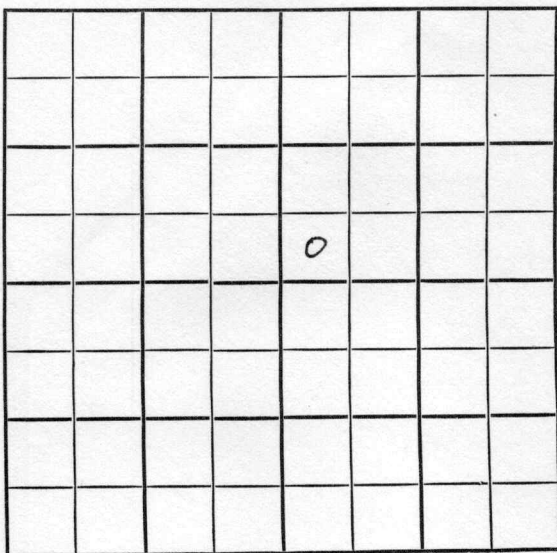

SOUTH

# Greenwood KANSAS

|      |      |     |
|------|------|-----|
| SEC. | TWP. | R.  |
| 18   | 24   | 12E |

WELL NO.

1 Fry FARM

COMPANY

Chas. Miller

CONTRACTOR

Baker

Virgil Pool

Ft. from N. Line


330

Ft. from S. Line

Ft. from E. Line

330

Ft. from W. Line

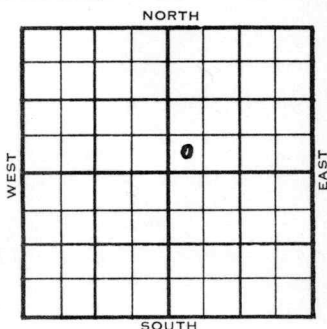

SW SW NE

ELEVATION

REPORT

1955

3/23

MICT

4/20

Spud 3-29-55 - Oil Well

TD 1816'

10" @ 35'

8" @ 645'

7" @ 1310'

Miss. 1785'

TD 1816'

5" @ 1808'

CO to 1816'

FU 100' oil 12 hrs.

B/12 bopd

C omp. 12 bopd

COMPLETED



County Greenwood State Kansas  
 Sec. 18 (Blk.) 24 (Sur.) 12E Map No. \_\_\_\_\_  
 Operator Chas. Miller  
 Well No. 1 Farm Fry  
 Elev. \_\_\_\_\_ Location SW SW NE

|  |  |  |  |  |  |  |  |
|--|--|--|--|--|--|--|--|
|  |  |  |  |  |  |  |  |
|  |  |  |  |  |  |  |  |
COMPLETE

330 Ft. From S Line NE  
330 Ft. From W Line Quarter  
 1st. Report \_\_\_\_\_  
 Completion APR 20 1955  
 Remarks Virgil Pool  
Baker - Contr.  
 Spudding Date 3-29-55

Drlg. Data Oilwell TD 1816  
10" @ 35 8" @ 645 7" @ 1310  
Miss. 1785 TD 1816 5" @ 1808  
C0 to 1816 FU 100' oil 12 hr.  
B/ 12 bopd Comp. 12 bopd

FABEN GILSTRAP