

KANSAS


Barton

FORM 51 IOM 12-46 PETROL

Section 31 Township 20 Range 15W

Well No. 7 Houdyshell

Company Phillips

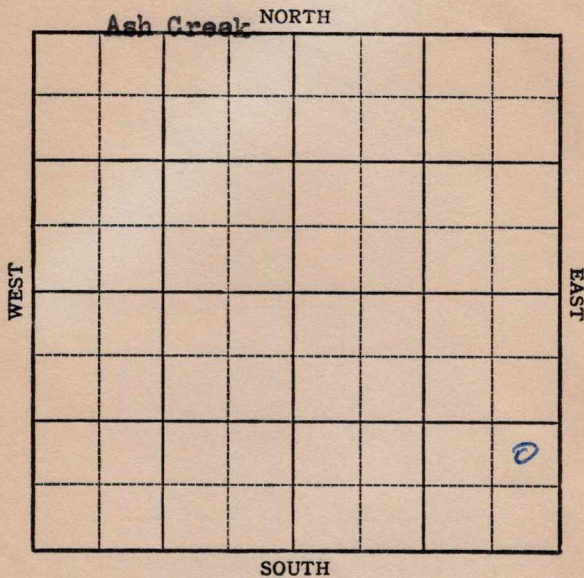

Barton

31 KANSAS

20

15W

Sec. _____ Twp. _____ R. _____

Well No. #7 Houdyshell Farm _____

Phillips Company

Ash Creek

Ft. from N. Line

990


Ft. from S. Line

330

Ft. from E. Line

Ft. from W. Line

NE SE SE

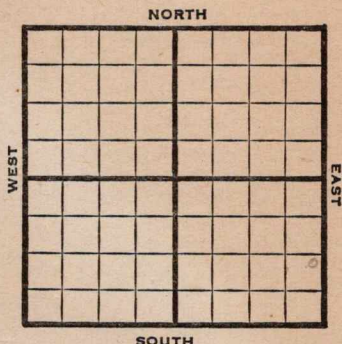

1947

Elev. 2002' REPORT

9/10

R U R

9/17

8" @ 1004'
Drlg. 3095'

9/24

Conglomerate 3729'
Landing 3452'
Viola 3739'
Simpson 3754'
Arbuckle 3793'
TD 3839'
5" @ 3838'
RUST

10/1

"

10/8

"

10/15

"

10/22

"

10/29

"

11/5

"

11/12

PB 3830½' - 20 shots. to 3822-27'
500 acid. Swb. 17 bbls. oil / 8W 15
hrs., 925,000 Gas.

11/19

"

11/25

"

12/3

"

OVER

1947

751646

12/10

PB 3830 $\frac{1}{2}$ '

20 shots 3822-27' - 500 acid

Swb. 17 bbls. oil & 8 W 15 hrs.

925,000 gas.

12/17

"

12/30

"

1948

1/7

"

1/14

"

1/21

Arb. 3793'

5" @ 3338'

Pump 15 oil / 20 W pot

39.0 Gr.

TD 3839 $\frac{1}{2}$ '

Comp.

COMPLETED

Map No. _____ Sec. 31 Twp. 20 R. 15W

Well No. 7 Houdyshell

Phillips Company

FIRST REPORT

Contractor

NE SE SE

SECTION PLAT

_____ Ft. from N. Line

990 Ft. from S. Line

330 Ft. from E. Line

_____ Ft. from W. Line

Barton County

Location _____

Rig up _____

Drilling and Remarks:

R U R

RECORD

Cased _____ in., _____ ft.

Sand _____

Gas _____

Oil _____

Total Depth _____

PRODUCTION

1st 24 hrs. Nat. _____

1st 24 hrs. after shot _____

Gas _____ Cu. Ft.

Dry Hole _____

Abandoned _____

Date

SEP 10 1947 19

S. J. LEWIS Scout

Map No. 82 Sec. 31 Twp. 20 R. 15W

Well No. 7 Houdyshell

Phillips Company

COMPLETE Contractor

NE SE SE

E 12002

SECTION PLAT

 Ft. from N. Line

990 Ft. from S. Line

330 Ft. from E. Line

 Ft. from W. Line

Barton County

Location

Rig up

Drilling and Remarks:

*Cr 3793
5' 03338*

*Pump 15 oil + 20W
P.D.*

39° 45'

RECORD

Cased in., ft.

Sand

Gas

Oil ✓

Total Depth 3889 1/2

PRODUCTION

1st 24 hrs. Nat.

1st 24 hrs. after shot

Gas Cu. Ft.

Dry Hole

Abandoned

Date

JAN 21 1948 19

S. J. LEWIS

Scout