

Map No. Kansas Sec. 19 Twp. 24 R. 12

Well No. 1 Ott Farm

John Stark et al Company

Miss Valley Oil Co

SOUTH

WEST

EAST

LOG

Location _____

Drilling Remarks _____

Rig Up _____

Drilling Remarks _____

RECORD

Cased _____ in. _____ ft.

Sand _____

Gas _____

Oil _____

Total Depth _____

PRODUCTION

1st 24 hrs. Nat. _____

1st 24 hrs. after shot _____

Gas _____ cu. ft.

Dry Hole _____

Abandoned _____

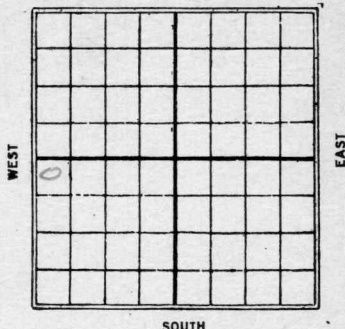
Map No. Kansas Sec. 19 Twp. 24 R 12Well No. 1 Ott FarmJohn Stark et al. Company

Miss Valley Oil Co NORTH

330200 Ft. from N. Line

Ft. from S. Line

Ft. from E. Line

330200 Ft. from W. LineDate 1925

REPORT

12/13 Location12/10 —12/11 —12/23 —12/31 —19261/8 Timbers1/14 —1/30 machine1/31 Rigging up.2/4 —2/10 Dlg 320'2/17 ✓ 660 (Chg owner)2/24 ✓ 900' (Acresage Con)3/5 ✓ 1300 " "3/16 Sand 1585-88 dry

Top miss 1830 Drilling 1840 (28)

3/18 S.D. 1875 45 feet in

lime No Break yet (28)

Top Bartsville Sand

1585-1588 Dry. Top Lime

1830' S.D. 1875 in hard black lime.

3/24- Will S.D. 1875 No Break. (2el)

3/25- _____

4/1- Same, will drill deeper -
(acreage contract)

4/7- _____

4/14- _____

4/21- S.D. 1912. Dry - abd.

Bville 1585-88 Top

line 1830.

Map No. KANSAS 16 Sec. 19 Twp. 24 R. 12

Well No. John 011 Stark et al Company

Contractor

SECTION PLAT

200 Ft. from N. Line

_____ Ft. from S. Line

_____ Ft. from E. Line

200 Ft. from W. Line

0			

FIRST REPORTS

Location ✓

Rig up _____

Drilling and Remarks:

RECORD

Cased _____ in., _____ ft.

Sand _____

Gas _____

Oil _____

Total Depth _____

PRODUCTION

1st 24 hrs. Nat. _____

1st 24 hrs. after shot _____

Gas _____ Cu. Ft.

Dry Hole _____

Abandoned _____

Date

DEC 3 1925

192

CHAS. L. SHERWOOD

Scout

860 Woodward Co
 Map No. *R16* KANSAS Sec. *19* Twp. *24* R. *12*

Well No. *1 off*
Miss Valley Oil Co Company

Contractor

CORRECTION

SECTION PLAT

o			

330

Ft. from N. Line

Ft. from S. Line

Ft. from E. Line

330

Ft. from W. Line

Location

Rig up

Drilling and Remarks:

only 660

*chjg ownership
to above. I
get the ad about it.*

RECORD

Cased _____ in., _____ ft.

Sand _____

Gas _____

Oil _____

Total Depth _____

PRODUCTION

1st 24 hrs. Nat. _____

1st 24 hrs. after shot. _____

Gas _____ Cu. Ft.

Dry Hole _____

Abandoned _____

Date

FEB 17 1926

192

CHAS. I. SHERWOOD

Scout

K16 KANSAS *19* Sec. *24* Twp. *12* R.
 Map No. _____ Well No. *1* *off*

Mrs. Sulley _____ Company
 _____ Contractor

COMPLETED

200 _____ Ft. from N. Line

_____ Ft. from S. Line

_____ Ft. from E. Line

200 _____ Ft. from W. Line

ABANDONED

SECTION PLAT

o			

Location _____

Rig up _____

Drilling and Remarks:

Well sd 158596

Top line 1830

DQW

20 1912

RECORD

Cased _____ in., _____ ft.

Sand _____

Gas _____

Oil _____

Total Depth *1912*

PRODUCTION

1st 24 hrs. Nat. _____

1st 24 hrs. after shot _____

Gas _____ Cu. Ft.

Dry Hole *✓*

Abandoned *✓*

Date

APR 21 1926

_____ 192

CHAS. L. SHERWOOD

Scout