

Map No. _____ Sec. 20 Twp. 24 R. 12
Well No. 1 Johnson Farm _____
Fisher Touch Company _____

NORTH

WEST

EAST

SOUTH

Location _____

Drilling Remarks:

Rig up _____

Drilling Remarks:

RECORD

Cased _____ in. _____ ft.

Sand _____

Gas _____

Oil _____

Total Depth_____

PRODUCTION

1st 24 hrs Nat. _____

1st 24 hrs. after shot_____

Gas _____ cu. ft.

Dry Hole _____

Abandoned _____

Map No. _____ Sec. 20 Twp. 24 R. 12

Well No. 1 Johnson Farm


Fisher Touch Company

_____ Ft. from N. Line

990 Ft. from S. Line

330 Ft. from E. Line

Ft. from W. Line

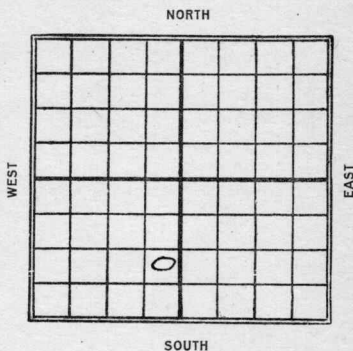

Date 1923

REPORT

$$\frac{6}{23}$$
$$\frac{8}{9}$$

Dep. 1300'

D. F. Q. 1926

Map No. **KANSAS** *16* Sec. *20* Twp. *34* R. *12*
 Well No. *1* *Jahmson*
Fisher Leuck Company

Contractor

FIRST REPORT

SECTION PLAT

----- Ft. from N. Line

990 ----- Ft. from S. Line

330 ----- Ft. from E. Line

----- Ft. from W. Line

	<i>0</i>		

Location -----

Rig up -----

Drilling and Remarks:

1300

RECORD

Cased ----- in., ----- ft.

Sand -----

Gas -----

Oil -----

Total Depth -----

PRODUCTION

1st 24 hrs. Nat. -----

1st 24 hrs. after shot -----

Gas ----- Cu. Ft.

Dry Hole -----

Abandoned -----

Date

M. A. BENEAR

JUN 23 1923

192

Scout

Map No. 16 Kansas 20 Sec. 24 Twp. 12 R. 12Well No. 1 JohnsonFisher & Lauck Company

Contractor

Abandoned

SECTION PLAT

Ft. from N. Line

990 Ft. from S. Line330 Ft. from E. Line

Ft. from W. Line

Location

Rig up

Drilling and Remarks:

L049
1926'

RECORD

Cased _____ in., _____ ft.

Sand _____

Gas _____

Oil _____

Total Depth _____

PRODUCTION

1st 24 hrs. Nat. _____

1st 24 hrs. after shot _____

Gas _____ Cu. Ft.

Dry Hole _____

Abandoned _____

Date

8/4 1923 WMB Scout