


Kansas Greenwood Co
Map No. *18* Sec. *24* Twp. *12* R. *12*
Well No. *1 Thrall* Farm
John Stark Company

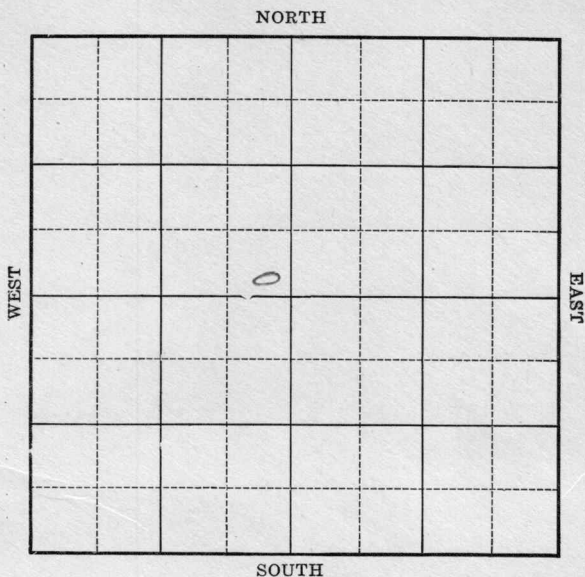

Location _____

Drilling Remarks _____

Rig Up _____

Drilling Remarks _____

RECORD

Cased _____ in. _____ ft.
Sand _____
Gas _____
Oil _____
Total Depth _____

PRODUCTION


1st 24 hrs. Nat. _____
1st 24 hrs. after shot _____
Gas _____ cu. ft.
Dry Hole _____
Abandoned _____

Map No. _____ Sec. 18 Twp. 24 R. 12Well No. 1 Thrall Farm
John Stark Company

_____ Ft. from N. Line

250' Ft. from S. Line250' Ft. from E. Line

_____ Ft. from W. Line

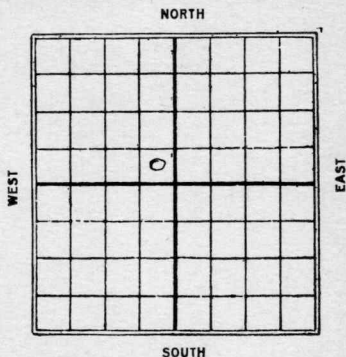1925

Date	REPORT
<u>10/1</u>	<u>Location</u>
<u>10/8</u>	_____
<u>10/16</u>	_____
<u>10/22</u>	_____
<u>10/29</u>	_____
<u>11/6</u>	_____
<u>11/16</u>	_____
<u>11/19</u>	_____
<u>11/27</u>	_____
<u>12/3</u>	_____
<u>12/10</u>	_____
<u>12/17</u>	_____
<u>12/23</u>	_____
<u>12/31</u>	<u>Only 235'</u>
<u>1926</u>	
<u>1/8</u>	<u>Only 750'</u>
<u>1/14</u>	<u>fishing string tools 1550'</u>
<u>1/30</u>	<u>Top line 1785' 1st break.</u> <u>1803-1809' filled up 750'</u> <u>14 hours, 38.5 Gravity</u>
<u>1/27</u>	<u>swabbing 35 lbs.</u> <u>(over)</u>

2/3- Top Lime 1785

1st break 1803-1809 T.D.

Pumping 35 Bbls mah

28.5 Gravity

16 Form 26—1M Bks.—3-23—11959. *Greenwood Co*
 Map No. **KANSAS** Sec. *18* Twp. *24* R. *12*

Well No. *1* *Thrall*
John Starks Company

Contractor

FIRST REPORTS

SECTION PLAT

Ft. from N. Line

250 Ft. from S. Line*250* Ft. from E. Line

Ft. from W. Line

Location ✓

Rig up

Drilling and Remarks:

RECORD

Cased _____ in., _____ ft.

Sand _____

Gas _____

Oil _____

Total Depth _____

PRODUCTION

1st 24 hrs. Nat. _____

1st 24 hrs. after shot _____

Gas _____ Cu. Ft.

Dry Hole _____

Abandoned _____

Date

OCT 1 1925

192

CHAS. L. SHERWOOD

Scout

16 KANSAS 18 Twp. 24 R. 12
 Map No. Sec. Twp. R.
 Well No. 1 Shall

John Stary Company
 Contractor

COMPLETED

SECTION PLAT

_____ Ft. from N. Line

250 _____ Ft. from S. Line

250 _____ Ft. from E. Line

_____ Ft. from W. Line

Location _____

Rig up _____

Drilling and Remarks:

Tap line 1785'

1st Break 1803'

1809' T.D.

dumping 35 bbs Nat.

Date

385 S. 3rd St.

RECORD

Cased _____ in., _____ ft.

Sand _____

Gas _____

Oil _____

Total Depth 1809'

PRODUCTION

1st 24 hrs. Nat. _____

1st 24 hrs. after shot _____

Gas _____ Cu. Ft.

Dry Hole _____

Abandoned _____

FEB 3 1926

192

CHAS. L. SHERWOOD

Scout